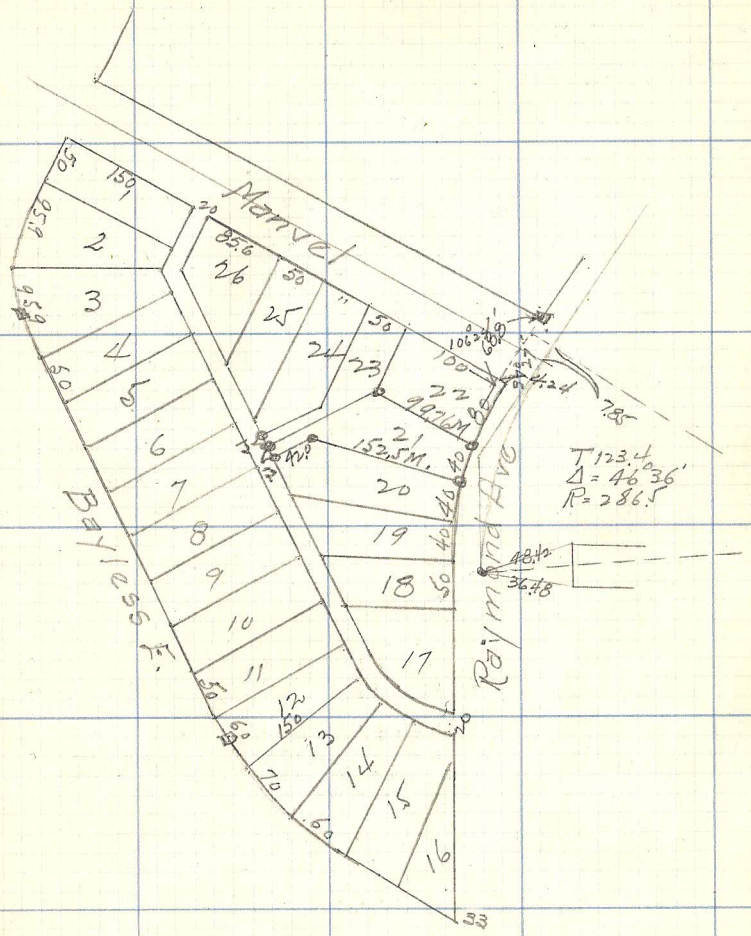Lot 21 Blk. 66.
St Anthony Park.