Lot 8 Blk 4
Jefferson Park Add.

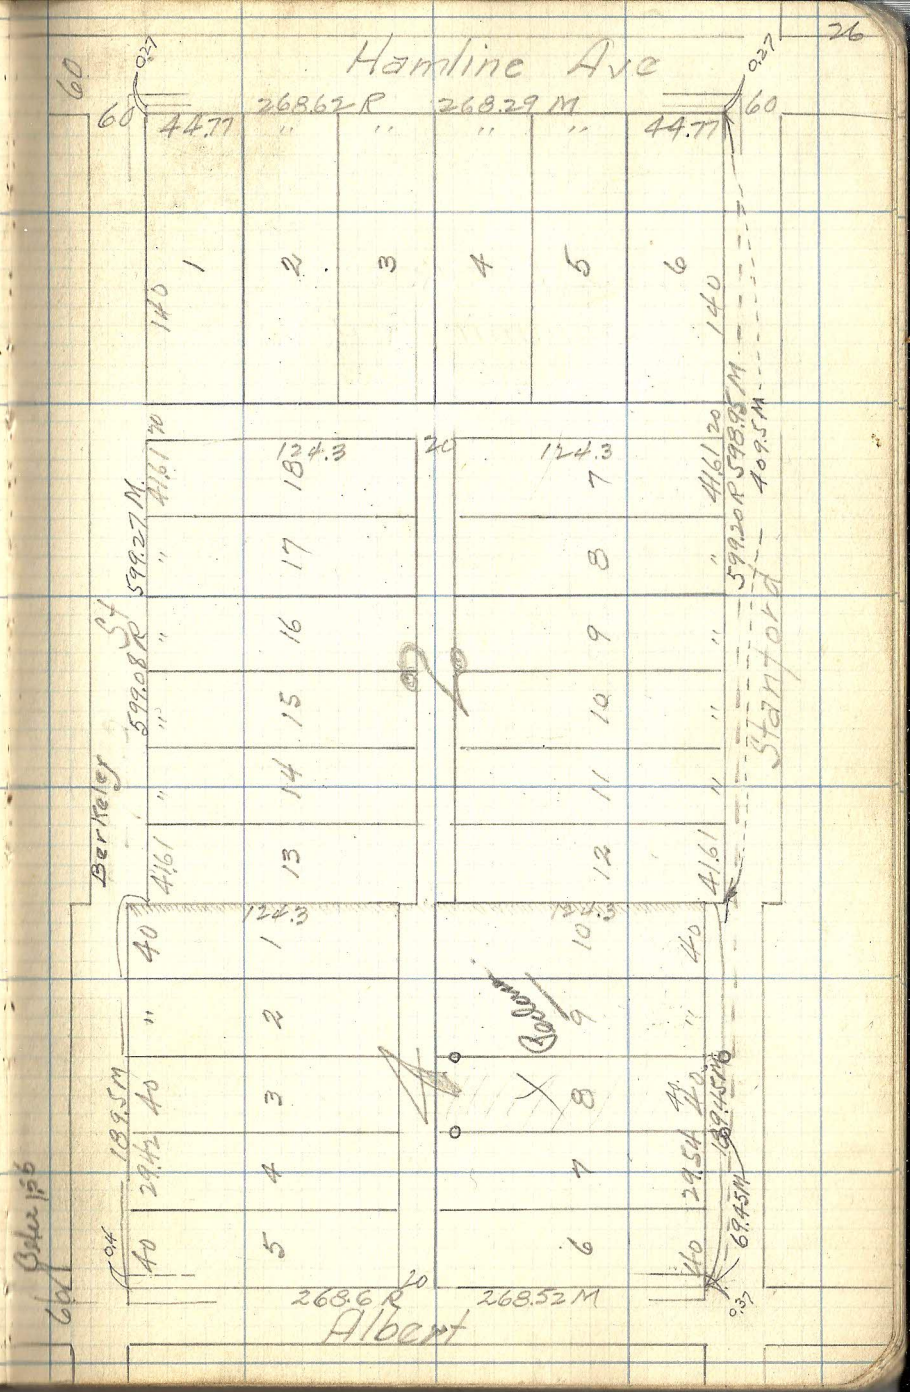
Hamline Ave
60
60
0.27
44.77
268.62 R
268.29 M
44.77
60
0.27
1
2
3
4
5
6
140
Berkeley
St
Stanford
St
599.08 R
599.27 M
599.20 R
598.85 M
409.5 M
411.61
411.61
411.61
411.61
20
20
124.3
124.3
124.3
124.3
18
17
16
15
14
13
12
11
10
9
8
7
1
2
3
4
5
6
40
40
40
40
40
40
40
40
40
40
40
40
188.5 M
39.42
39.54
39.54
39.54