


Lot 24 Blk 30  
 Gotzians Re.Ar. of  
 Sigels Add.

Johnson Parkway

Minnehaha

60  
 60

Beech St

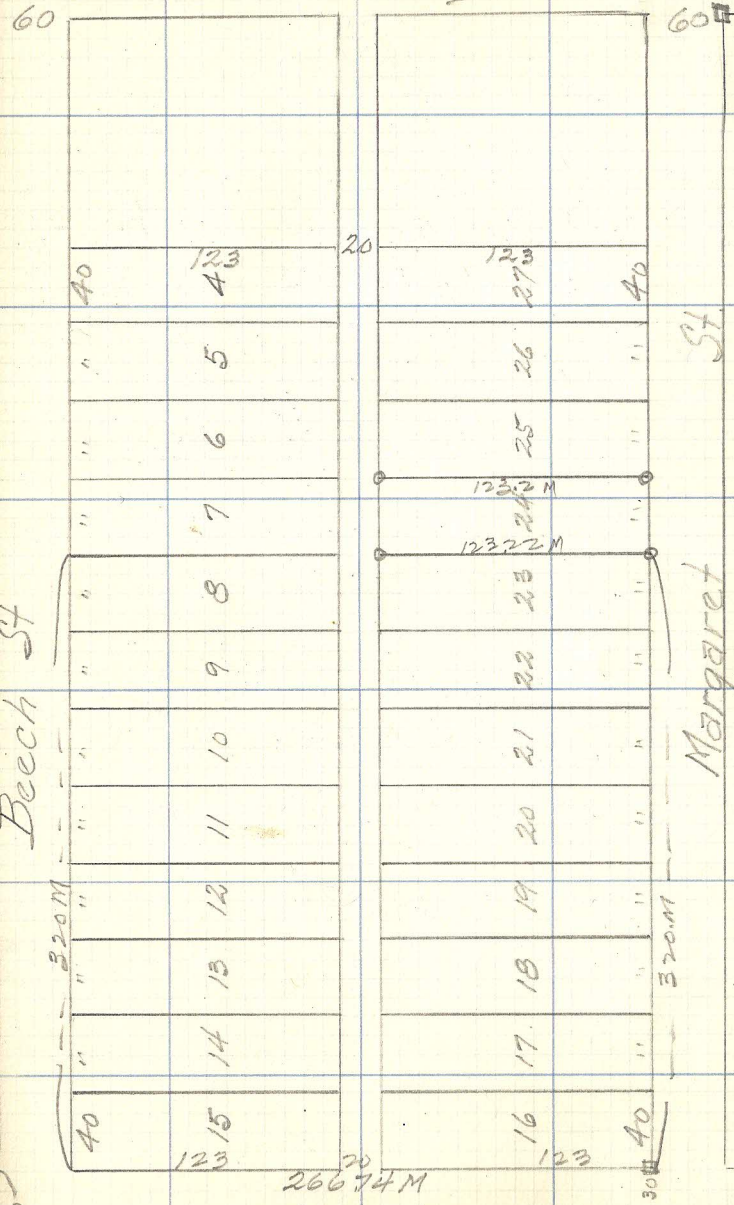

Atlantic

Margaret St

No Line 6th St.

30 30