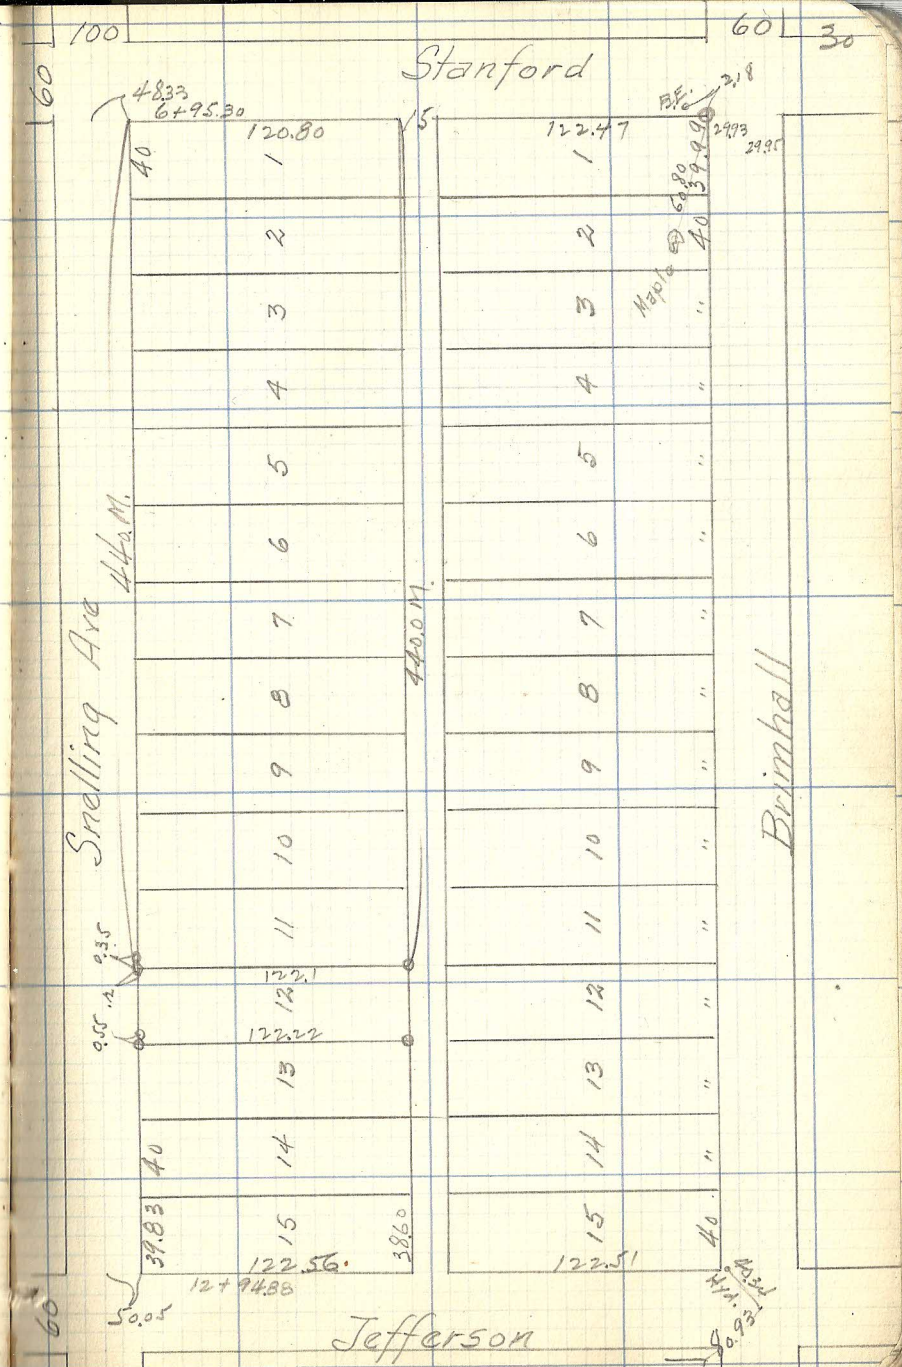Lot 12 Blk 5
Evergreen's Re. Ar.
Sylvan Park Add.