


Lot 24 Div. 4.
 Chute Bros. Divs.

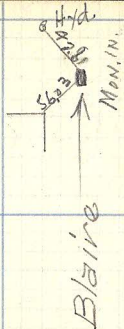

60

Lafond.

| | | | | | | | | | | | | | | | | | |
|------|----|----|----|----|----|----|----|----|----|----|----|----|----|----|----|-----|----|
| 3387 | 40 | 14 | 13 | 12 | 11 | 10 | 9 | 8 | 7 | 6 | 5 | 4 | 3 | 2 | 1 | 124 | 40 |
| 3402 | 40 | 17 | 18 | 19 | 20 | 21 | 22 | 23 | 24 | 25 | 26 | 27 | 28 | 29 | 30 | 124 | 40 |


St Albans

Date 5th

66

31

32.90

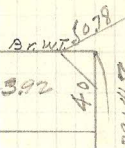

Thomas