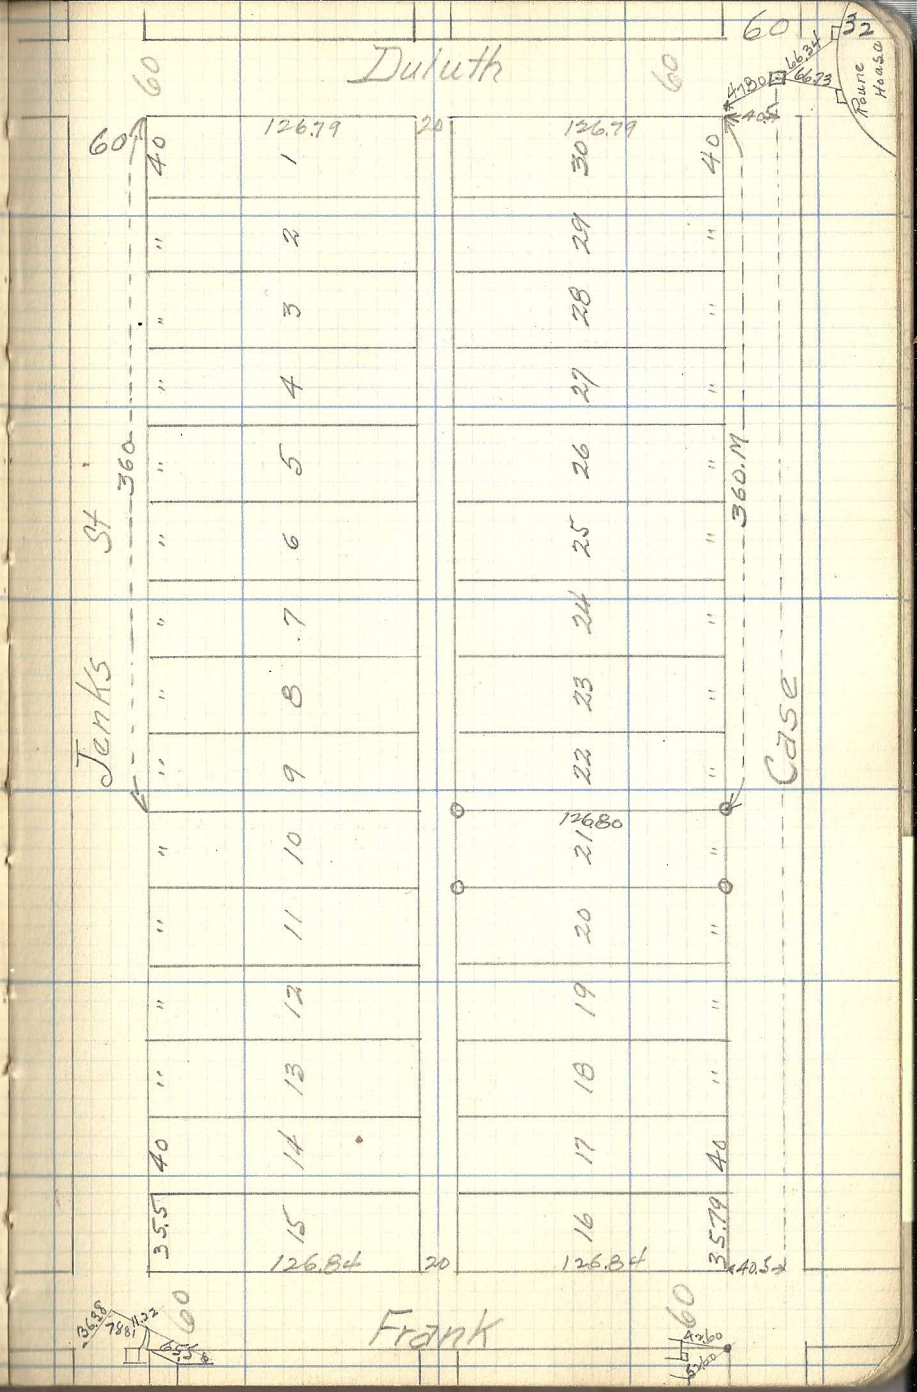Lot 21 Blk 8.
Hillsdale