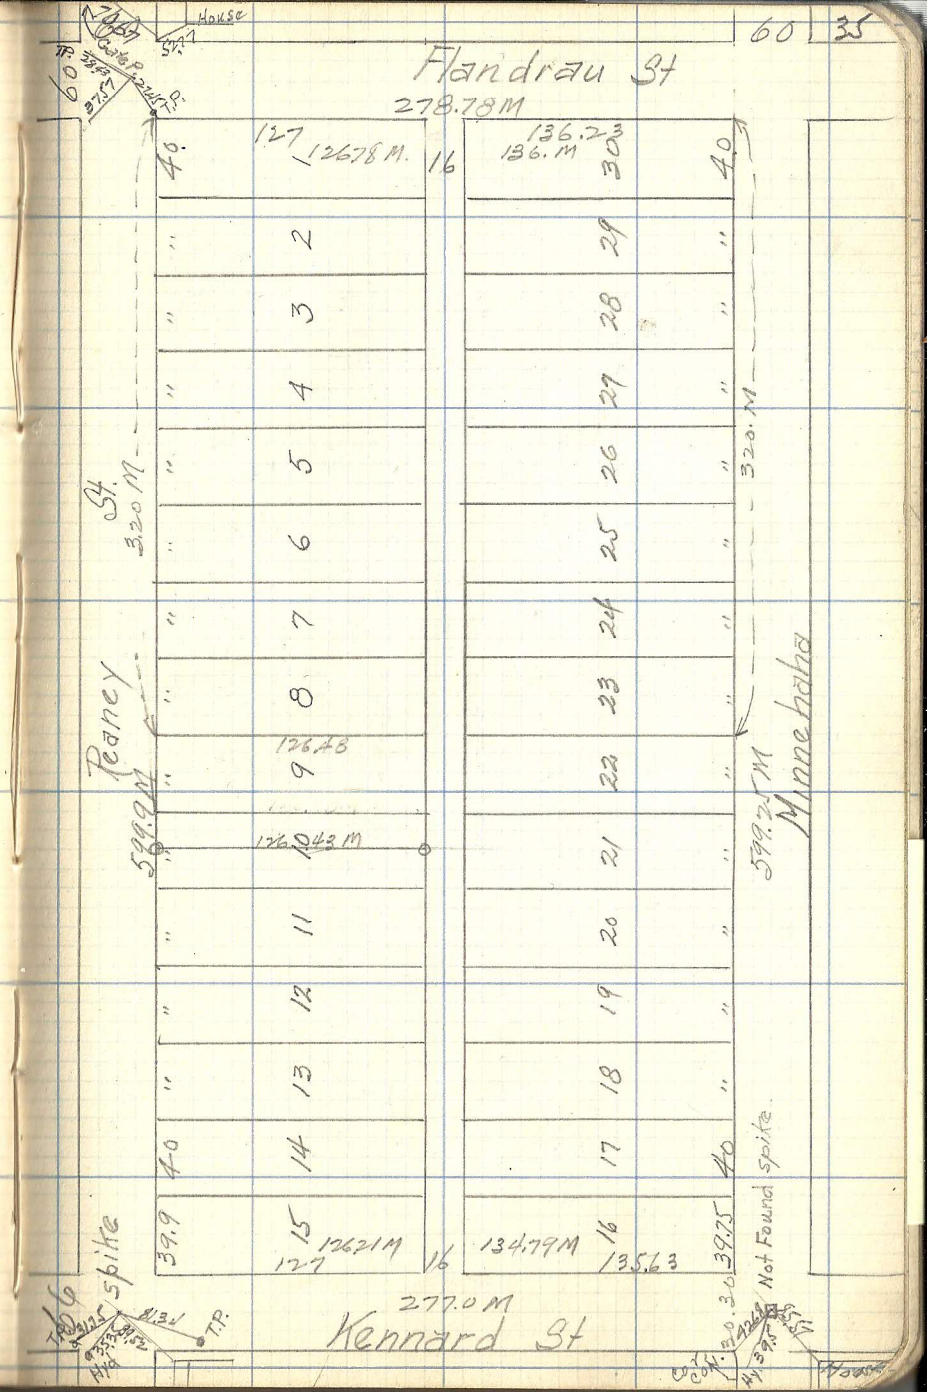Lot 9 & E½ Lot 10
J.N. Rogers 4th Add.