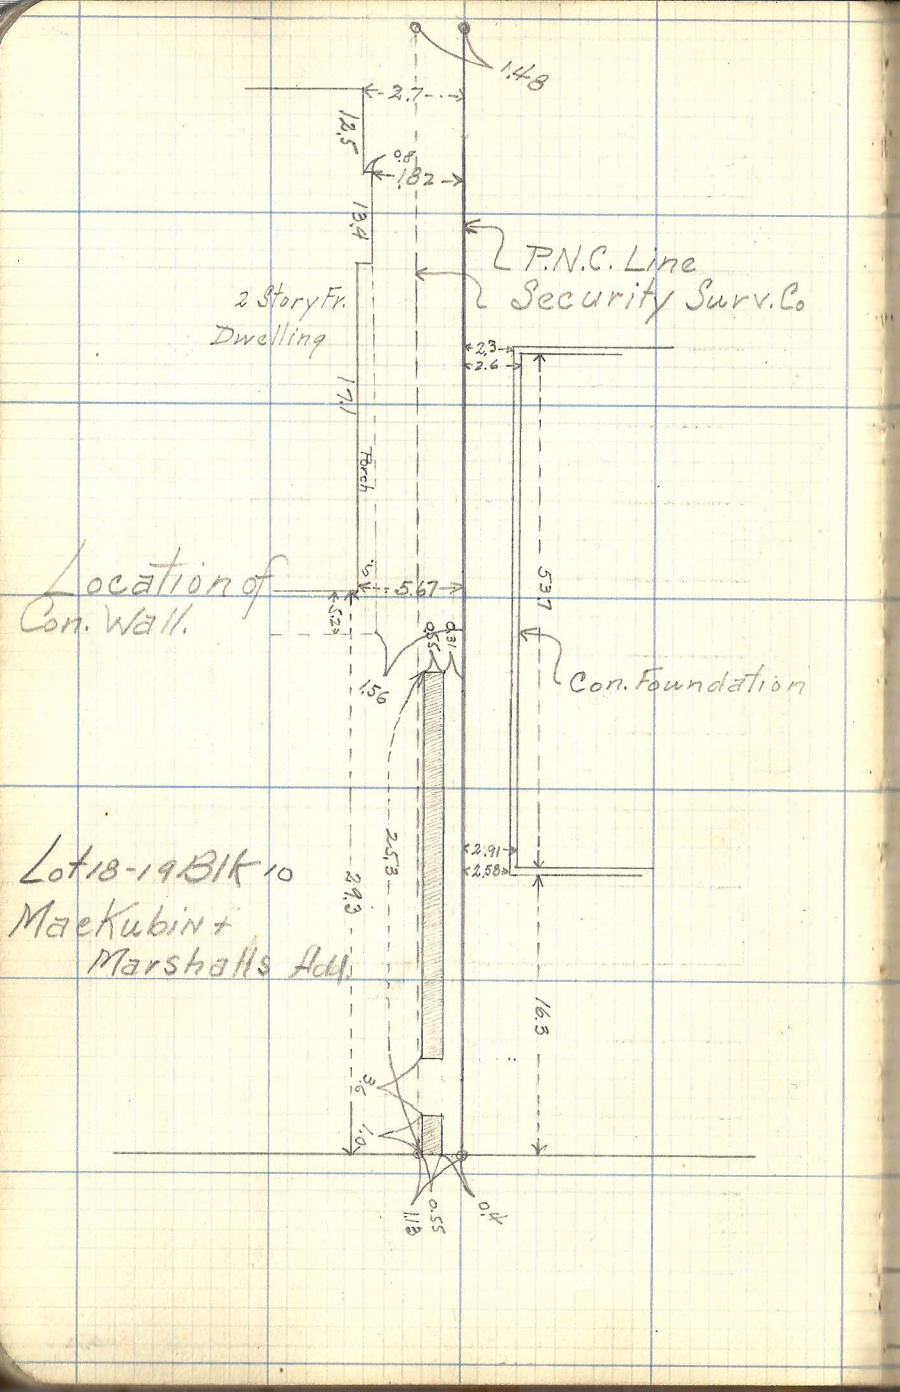
1.48
2.7
12.5
0.6
1.82
18.4
P.N.C. Line
Security Surv. Co
2 Story Fr.
Dwelling
2.3
2.6
14.1
Porch
5.67
5.37
Location of
Con. Wall.
1.56
Con. Foundation
2.91
2.58
Lot 18-19 Blk 10
MacKubin +
Marshalls Add.
24.3
25.3
16.3
3.6
0.1
0.4
8.11
0.55

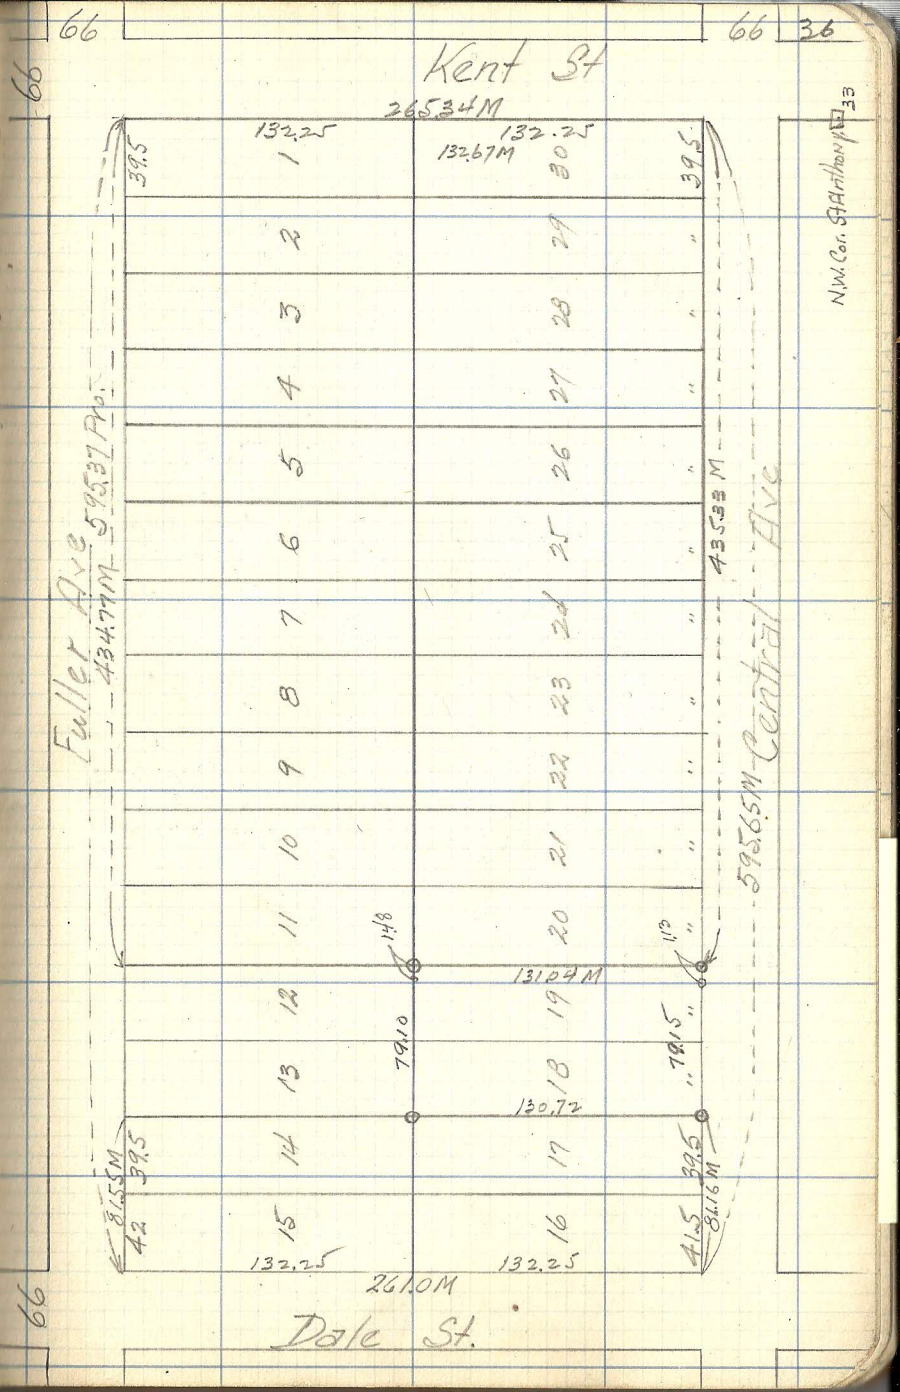
66
66
66
36
Kent St
265.34M
132.25
132.67M
132.25
39.5
39.5
1
2
3
4
5
6
7
8
9
10
11
12
13
14
15
16
29
28
27
26
25
24
23
22
21
20
19
18
17
30
Fuller Ave
134.77M
595.37 Prof.
435.38 M
595.65M
Central Ave
33
1.48
1.48
131.04M
79.10
79.15
130.72
8.55M
39.5
8.16M
39.5
4.2
4.15
132.25
132.25
261.0M
Dale St.