


# Gallagher's Goat Ranch.

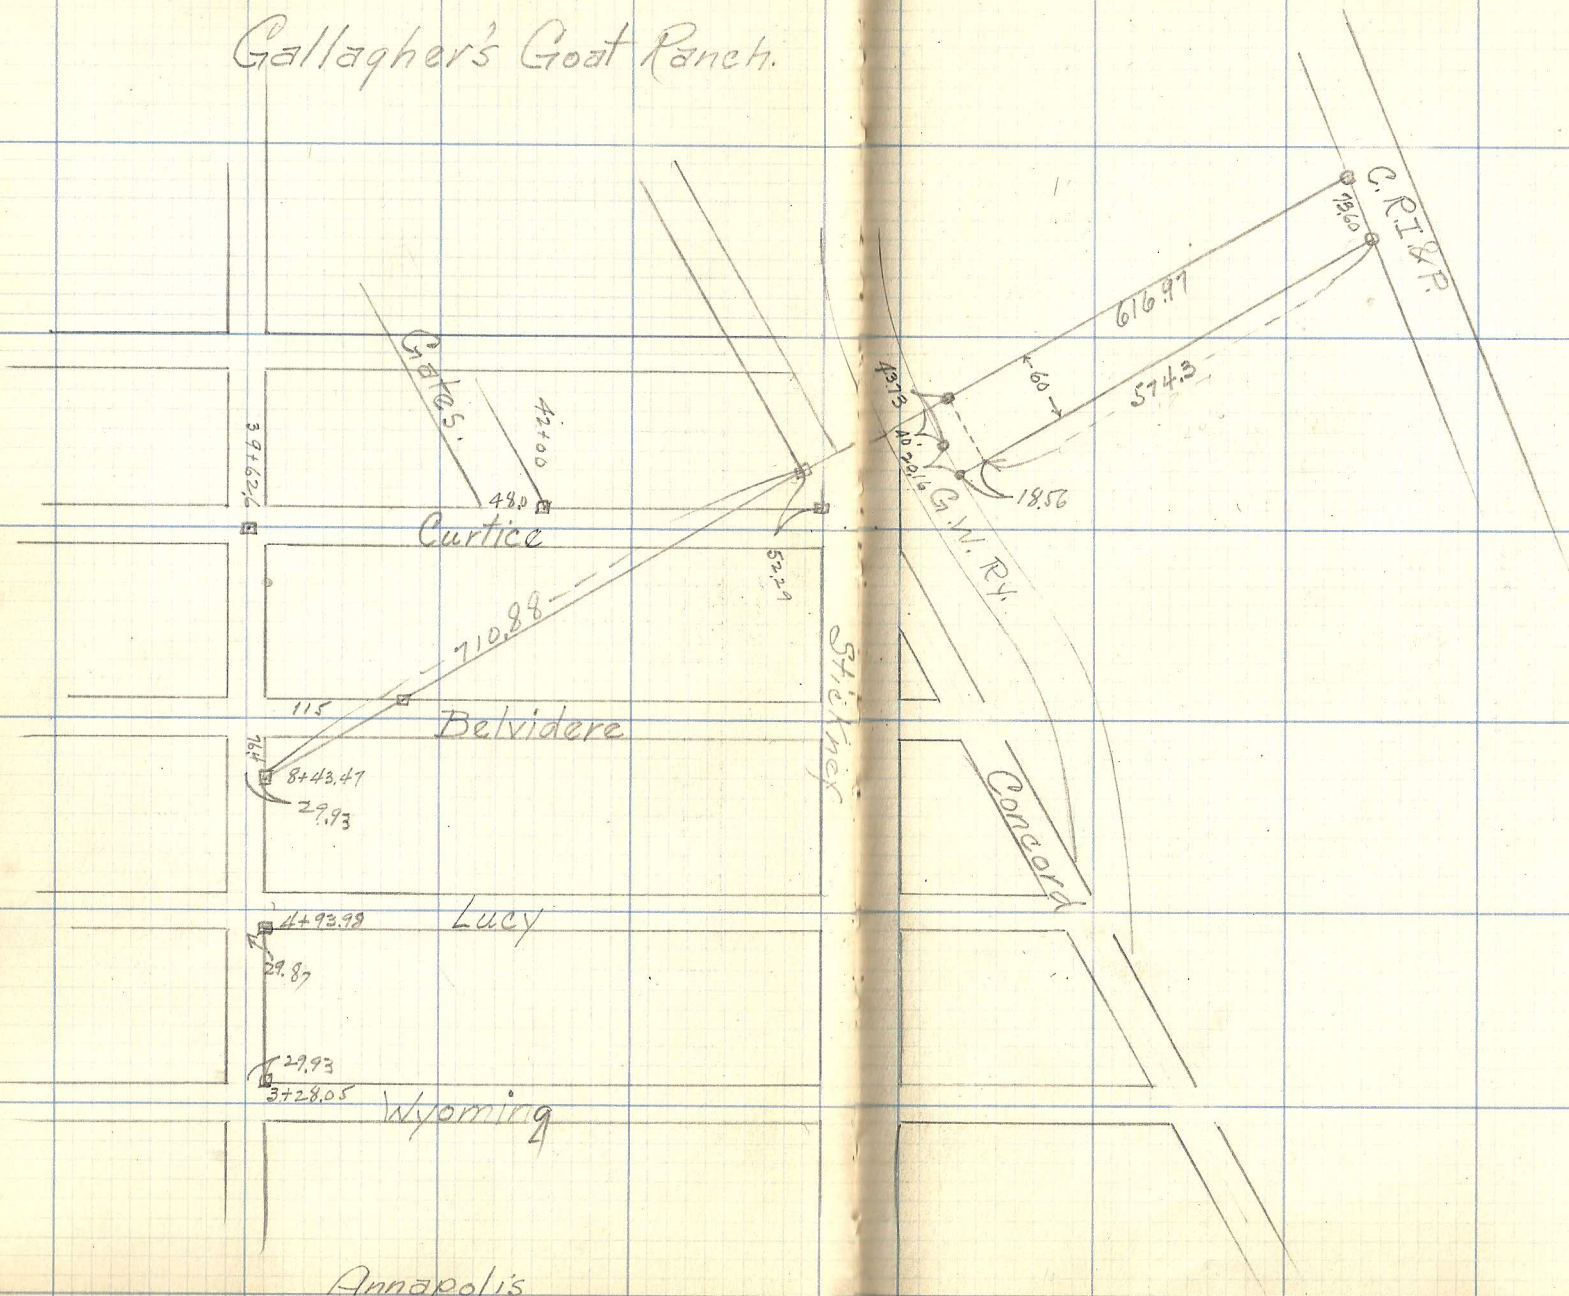

Annapolis