

GOODRICH


SMITH'S ADD.
LOT 3

33

GOODHUE

SUPERIOR ST.

ST.

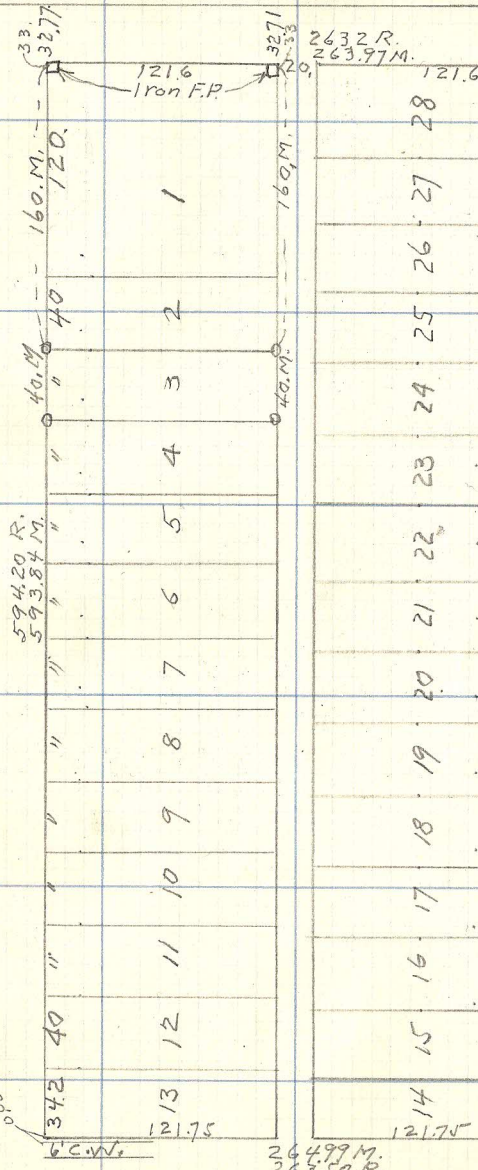

WESTERN AVE.

33

3271

20

169 M.

121.6

2632 R.

26397 M.

26499 M.

26350 R.

331

COR. STONE











RICHMOND ST.

ST.

MICHIGAN

WEST