


Lots 70-71 Div Blks 2-3
Lake Shore Park.

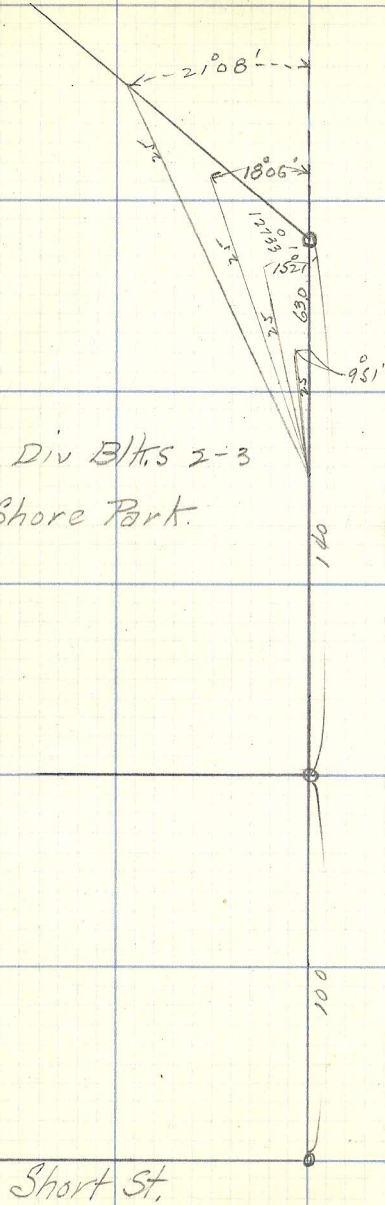

Short St.