


= N.W. Cor. Margaret & Farrell

# Farrell's Add.

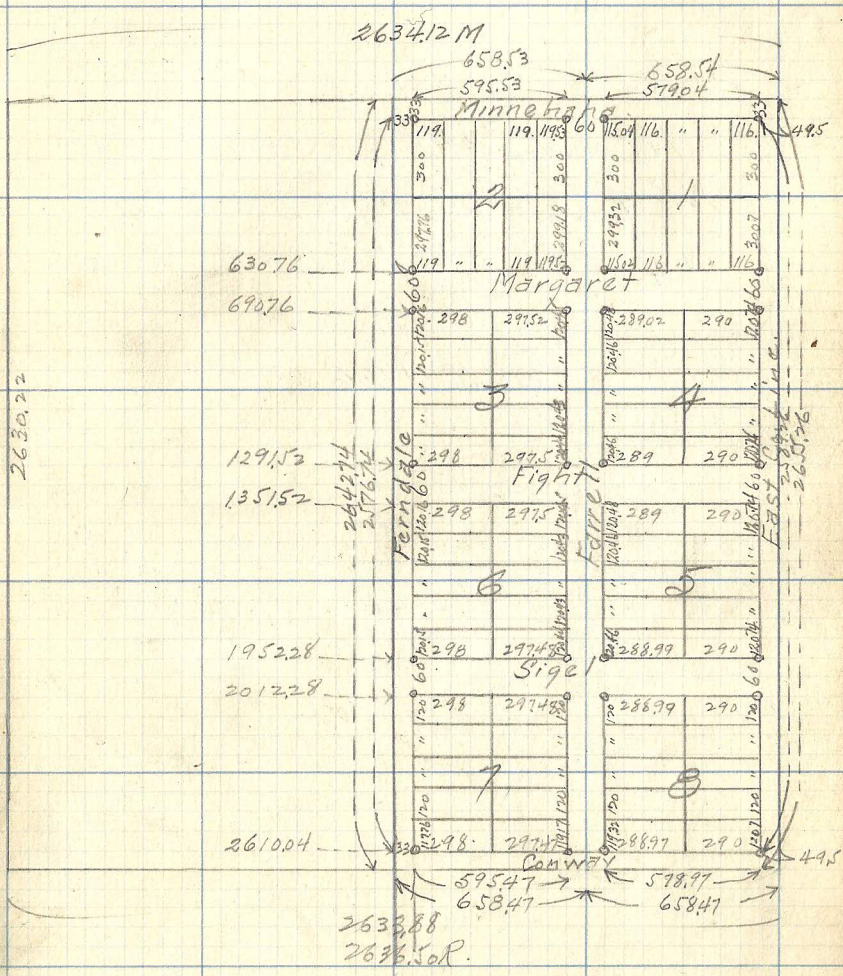

	2634.12 M		658.53		658.54		
	595.53		579.04		579.04		
	1330	119	119	119	116	116	495
	300	300	300	300	300	300	
630.76	119	"	119	"	116	"	
690.76	Margaret						
	298	295	298	290	290	290	
	3		4				
1291.52	298	295	298	289	290	290	
1351.52	Fight						
	298	295	298	289	290	290	
	6		5				
1952.28	298	295	298	288.99	290	290	
2012.28	Sige						
	298	295	298	288.99	290	290	
	7		8				
2610.04	298	295	298	288.99	290	290	
	Conway						
	595.47		578.97		578.97		
	658.47		658.47		658.47		
	2633.88						
	2636.50 R.						