Gilbert & Gilbert
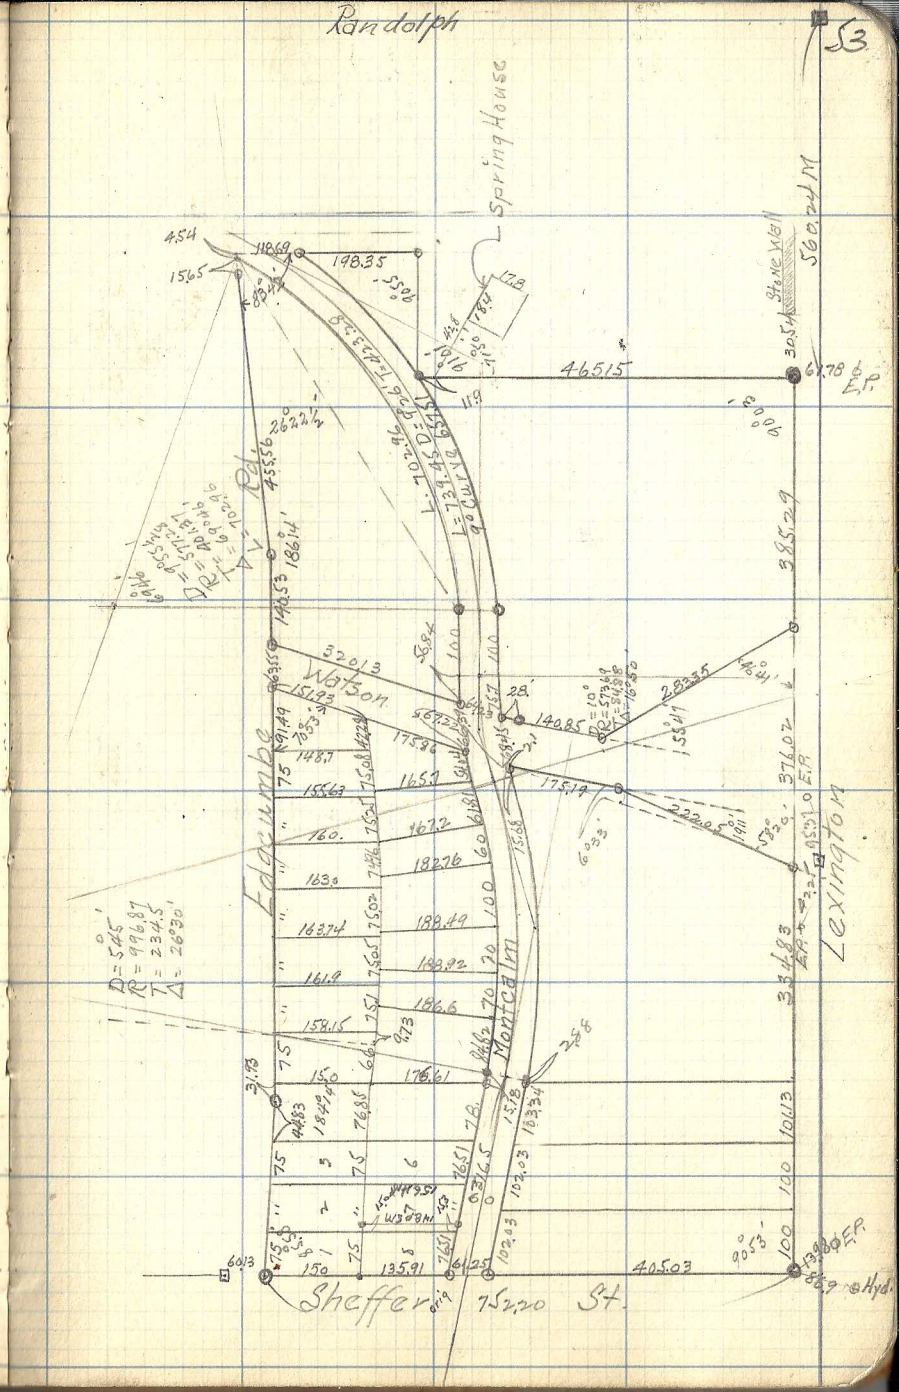
Edgecumbe Rd. & Montcalm.