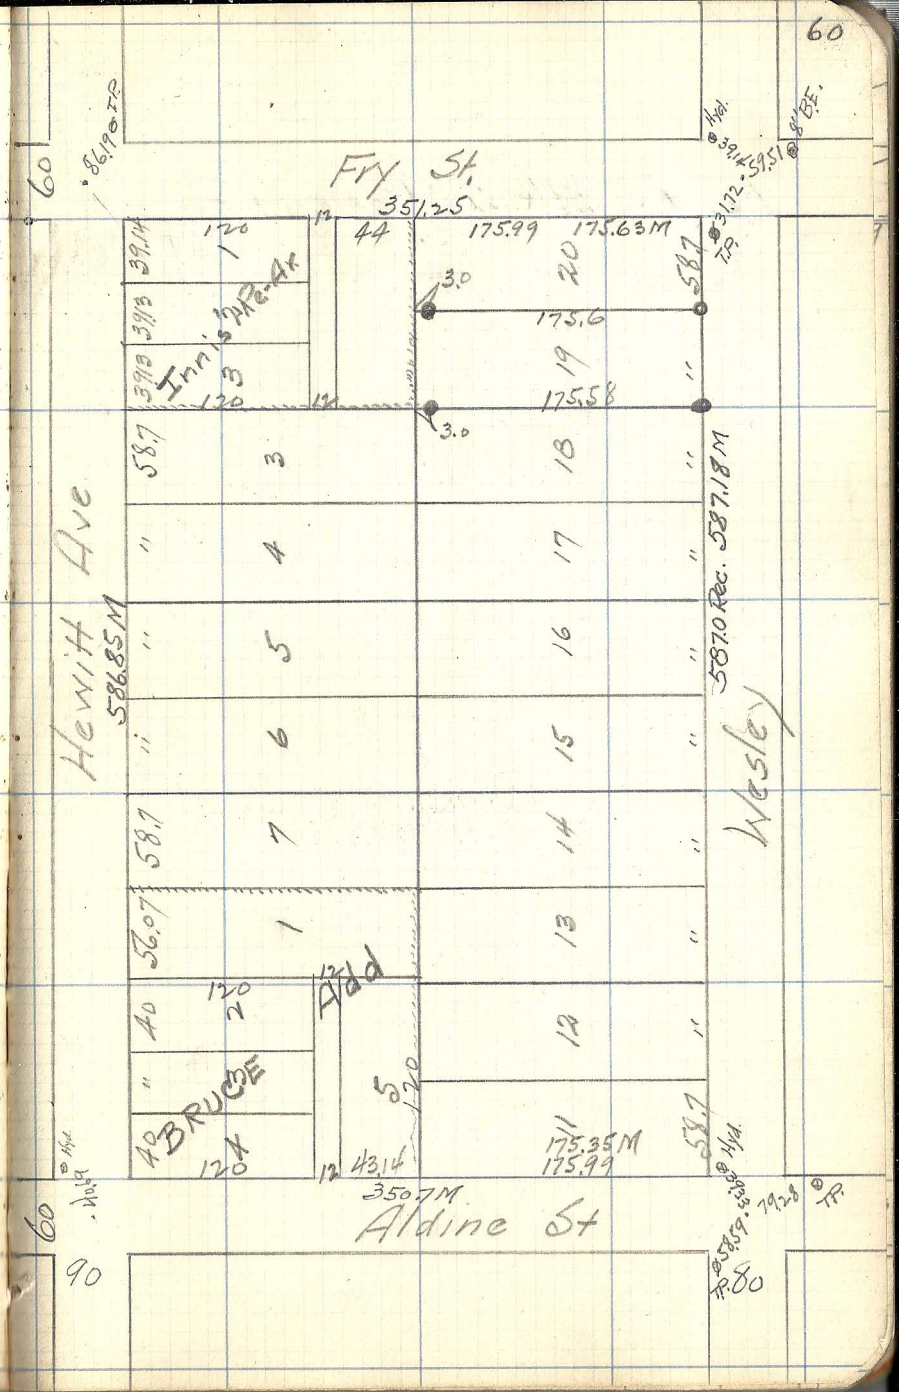Lot 19 Blk 2 College Pl. West Div.