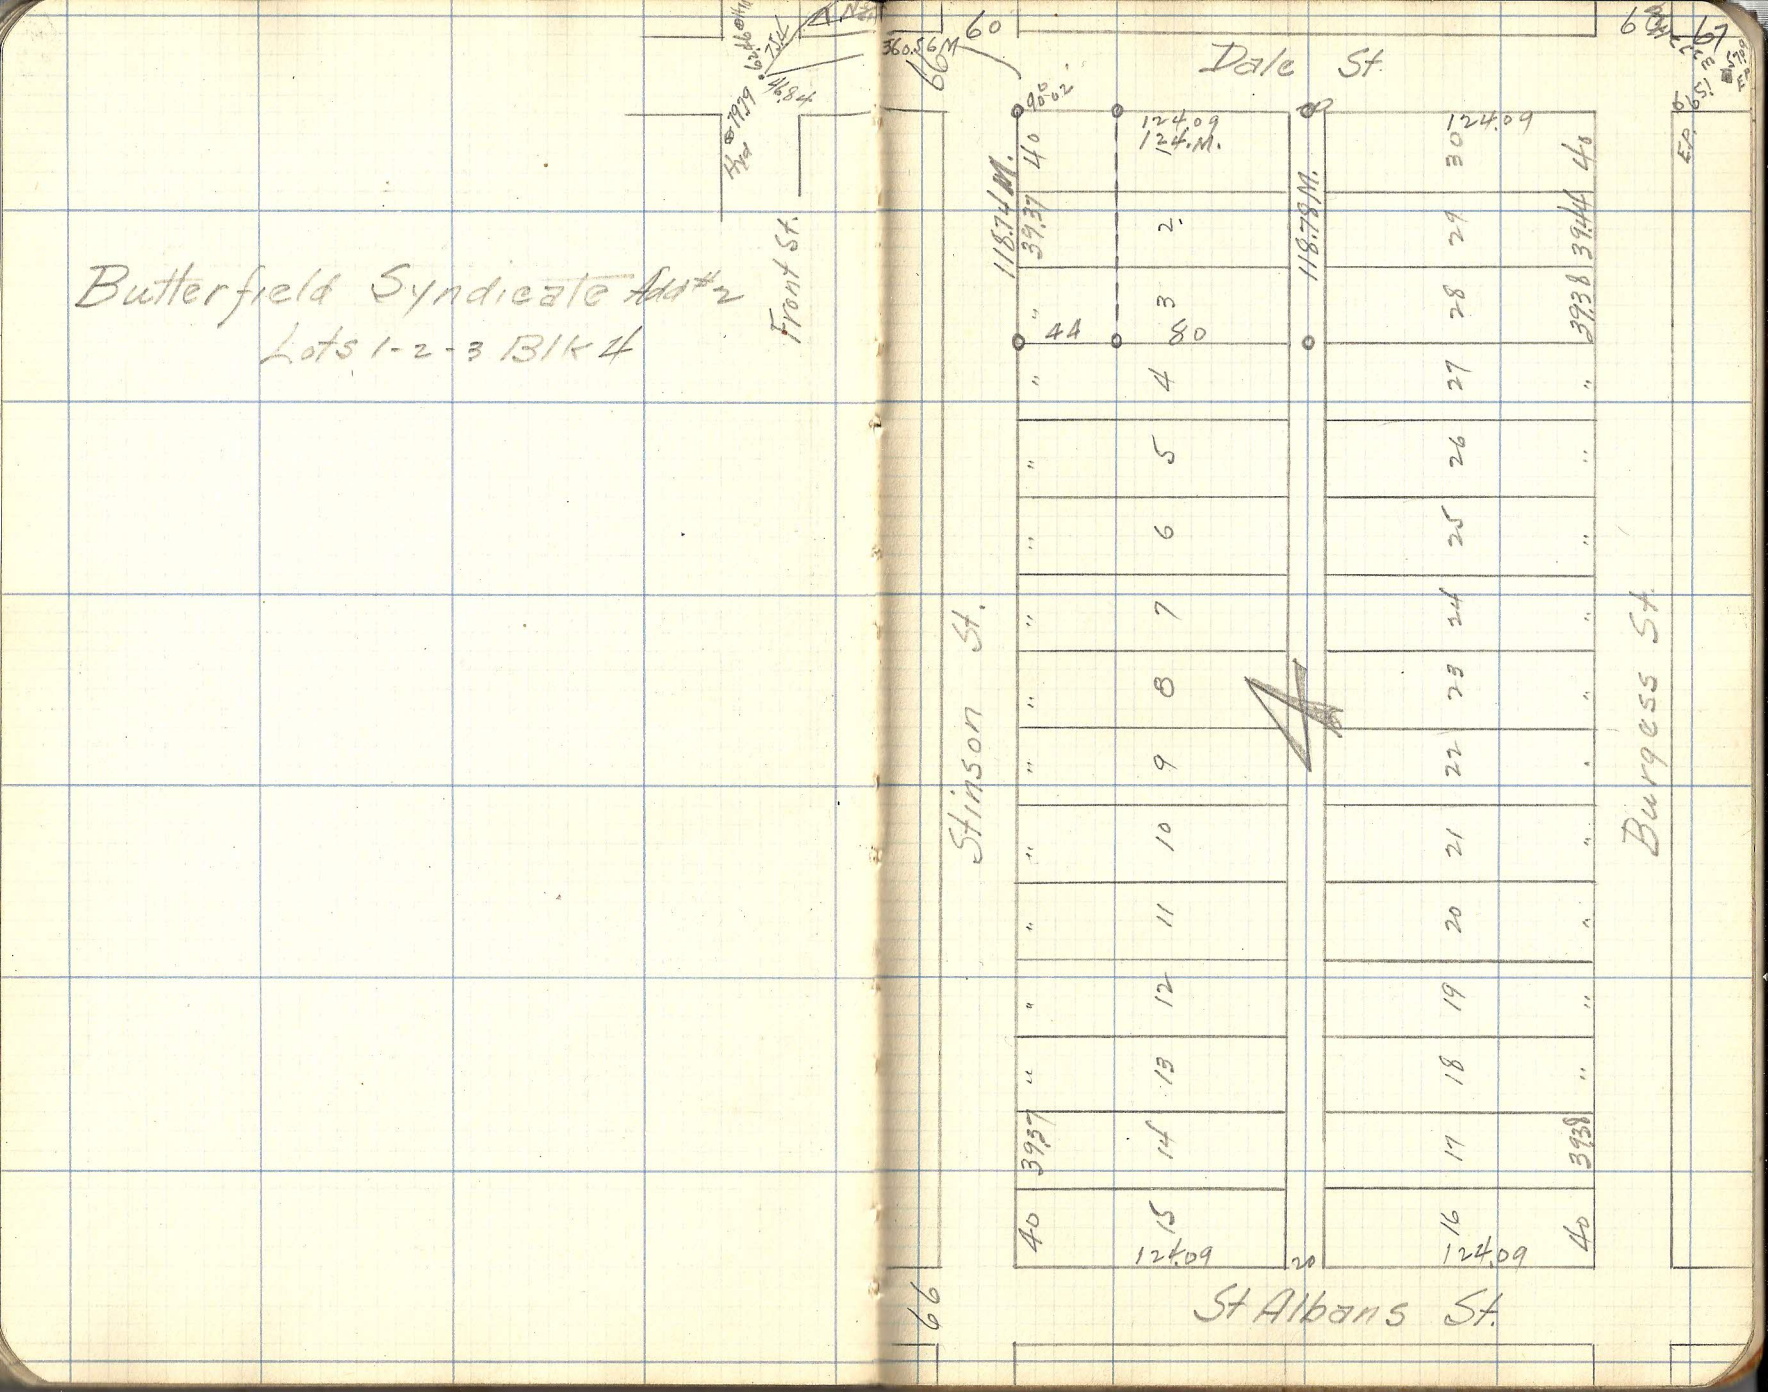
Butterfield Syndicate Add#2
Lots 1-2-3 Blk 4
Front St.
Dale St.
Stinson St.
Burgess St.
St Albans St.
66
118.74 M.
118.79 M.
124.09
124.M.
39.37
39.44
39.38
40
44
80
20
66 FEET