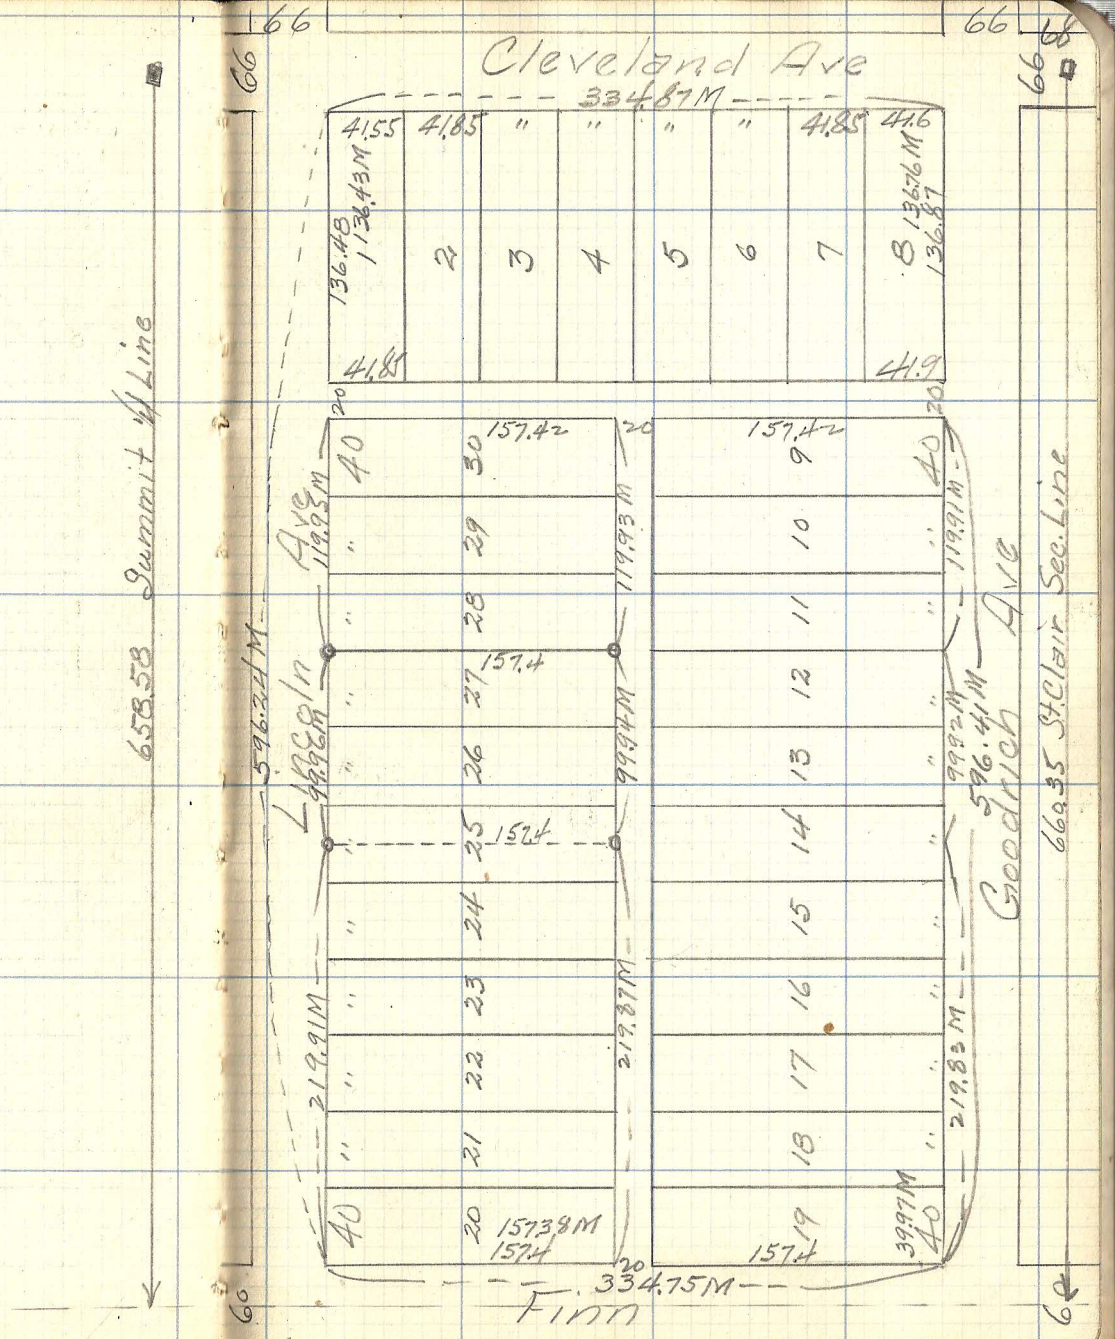Lots 26-27 & E½ of 25
Blk. 3 Groveland Add.