LINDAU'S ADD.
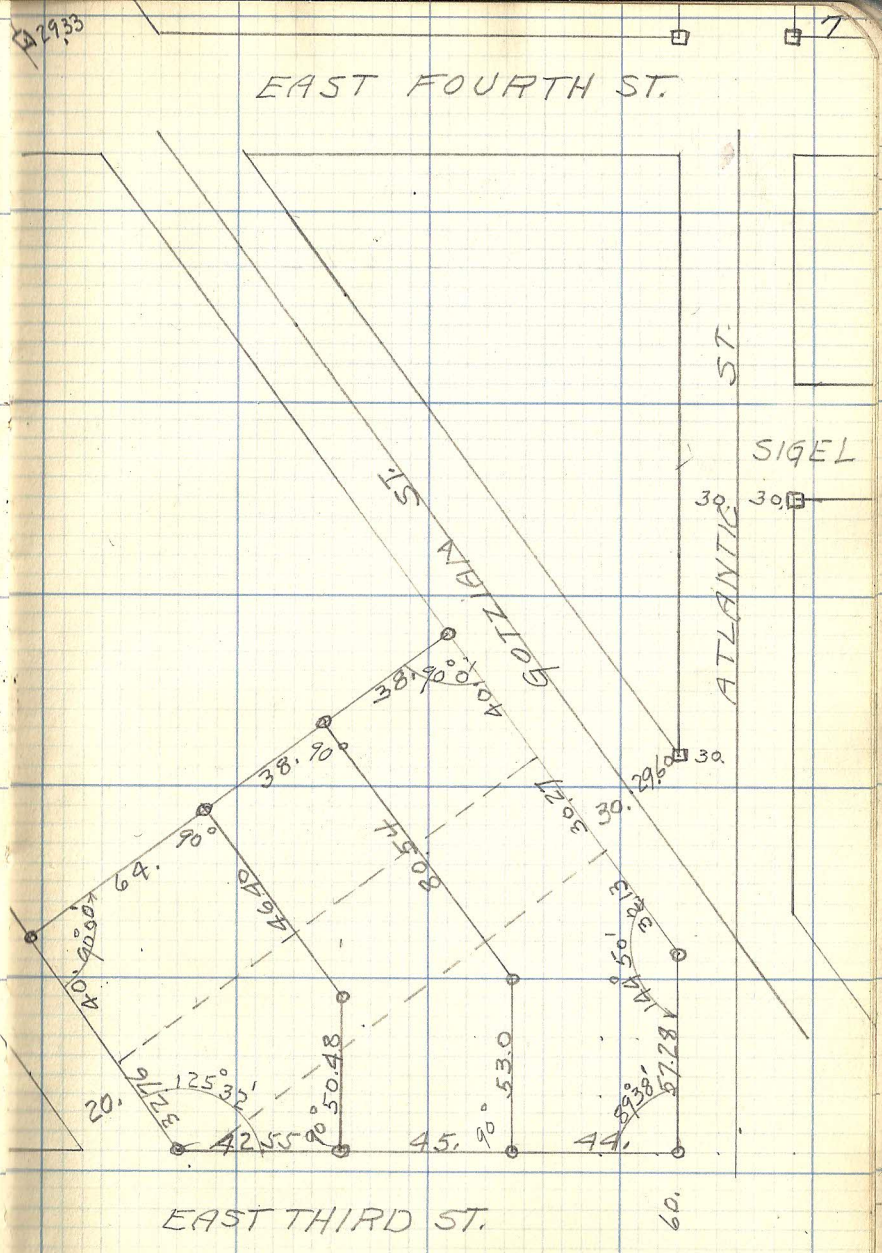
1924