
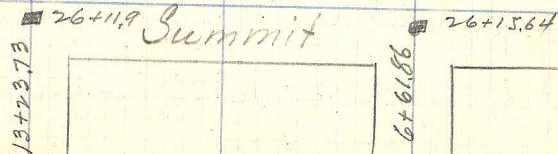
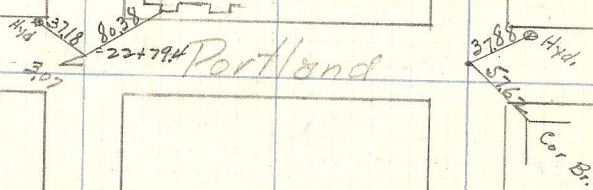
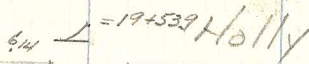
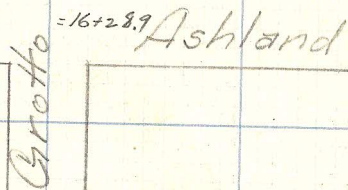



Lot 7 BK. 14 Holcombe's Add.

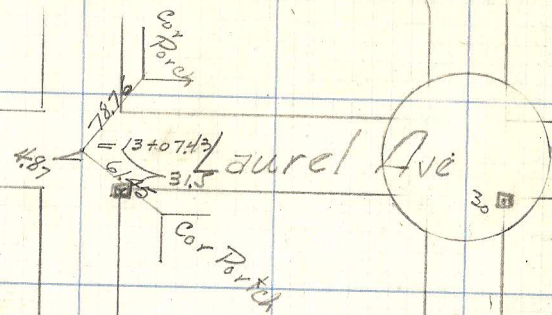

66

St Alban's

66 70

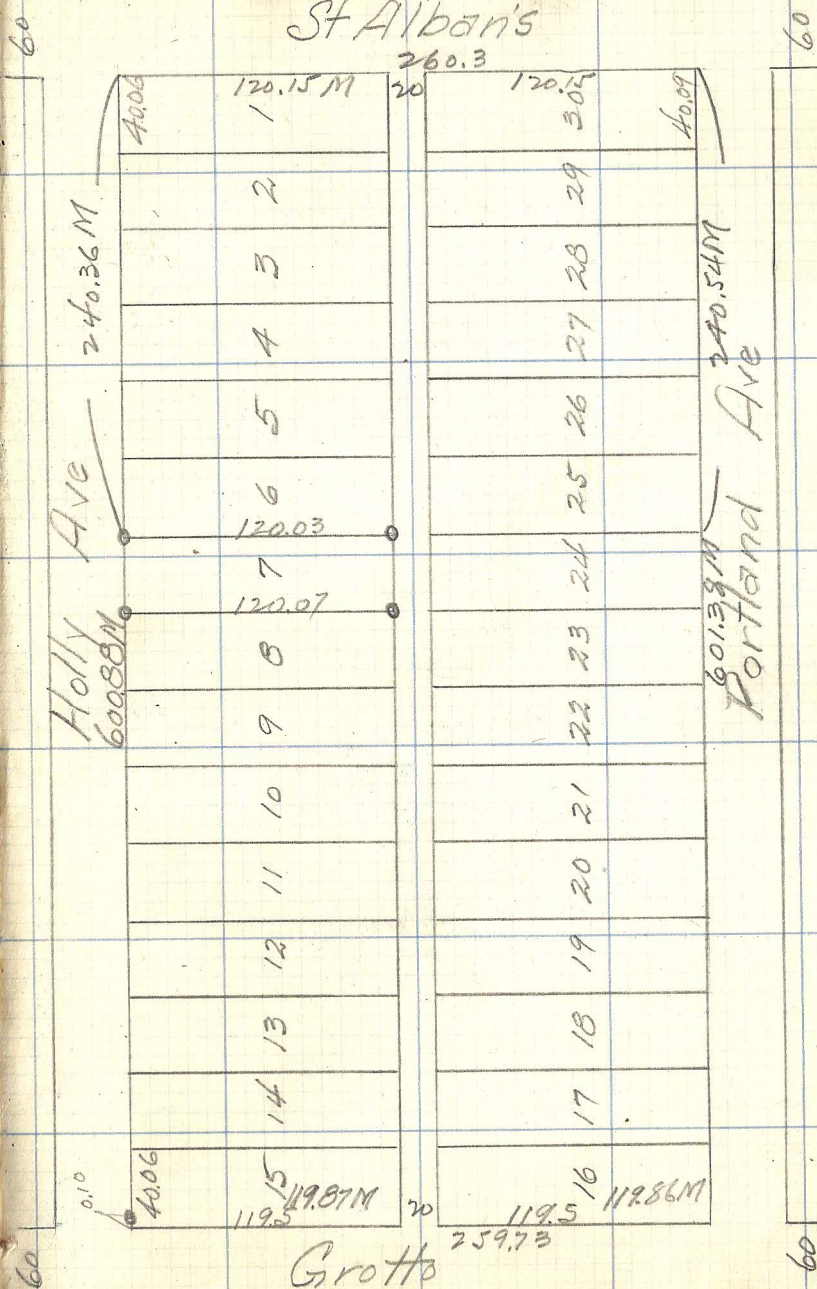

60

60