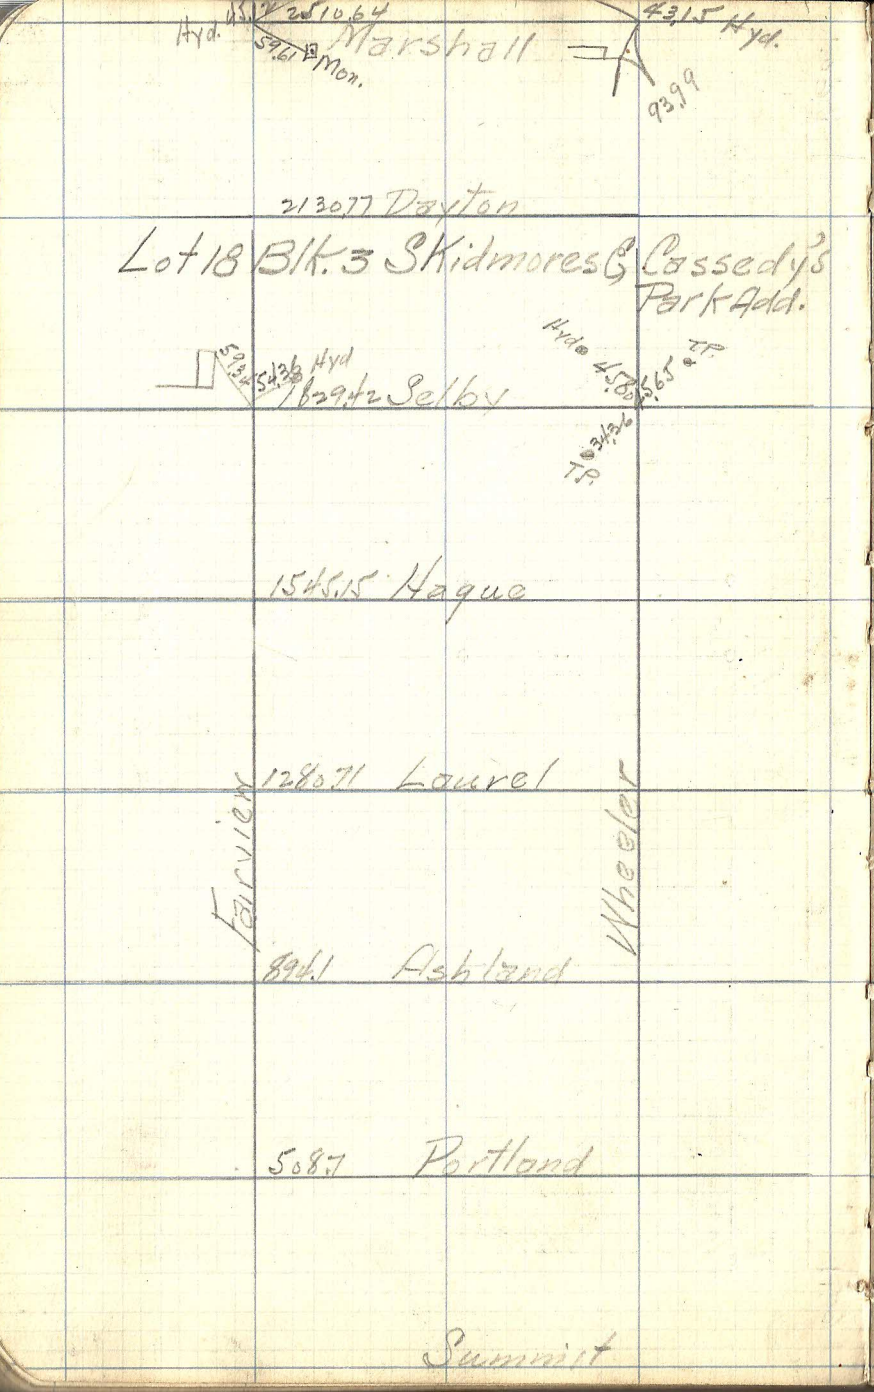
Hyd. 45.17 2510.64
59.61 Mon.
Marshall
43.15 Hyd.
93.99
2130.77 Dayton
Lot 18 Blk. 3 Skidmores & Cassedy's Park Add.
59.34 54.36 Hyd
1829.42 Selby
Hyd 45.80 45.65 T.P.
34.36 T.P.
1545.15 Hague
1280.71 Laurel
Fairview
Wheeler
894.1 Ashland
508.7 Portland
Summit

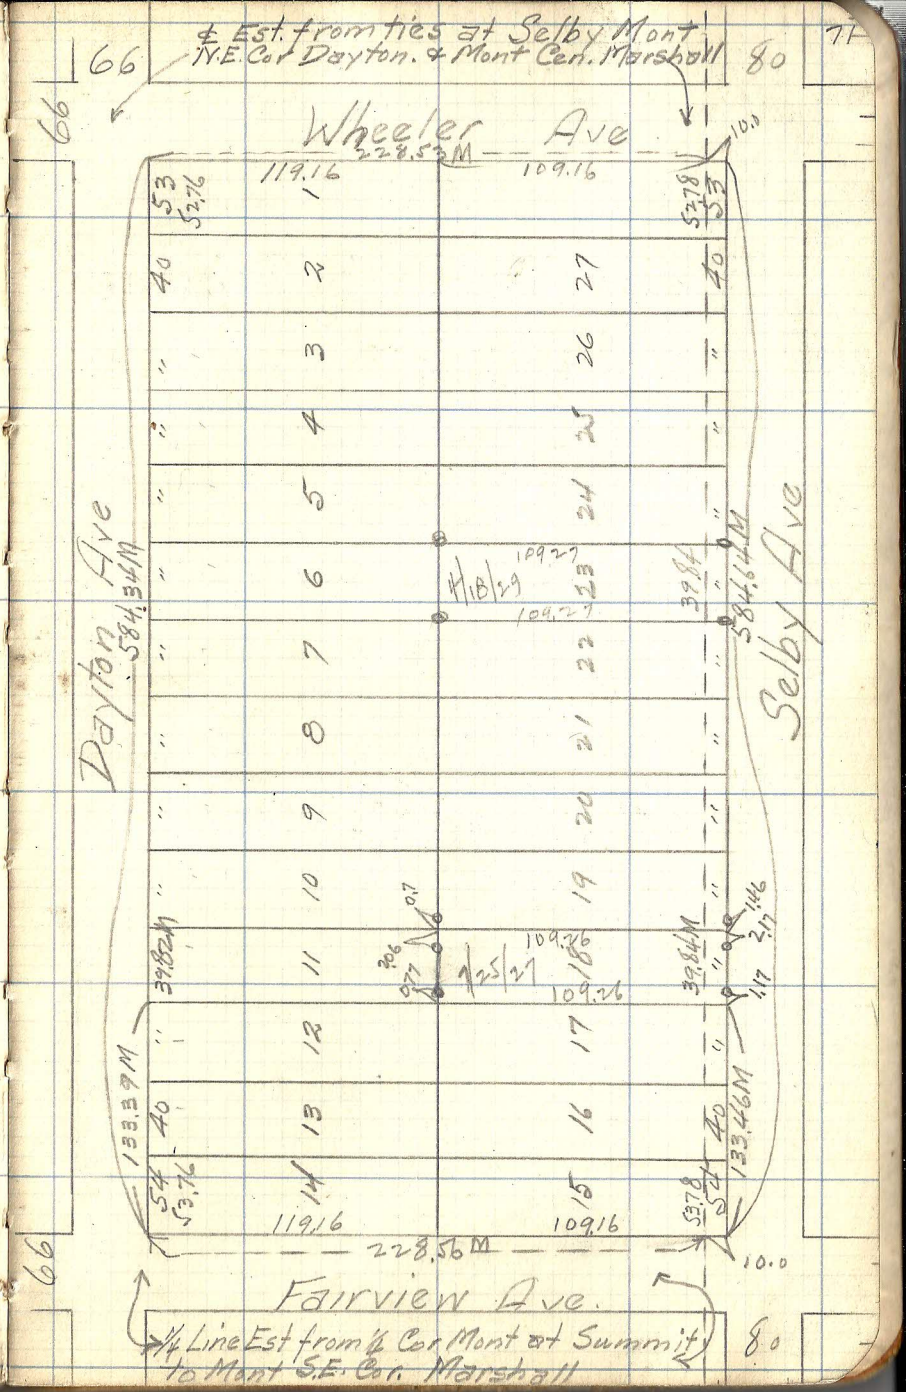
66
℄ Est. from ties at Selby Mont
N.E. Cor Dayton. & Mont Cen. Marshall
80
77
Wheeler Ave
228.53 M
119.16
109.16
10.0
53 52.76
52.78 53
40
27
26
25
24
23
22
21
20
19
18
17
16
15
14
13
12
11
10
9
8
7
6
5
4
3
2
1
Dayton Ave
584.34 M
Selby Ave
584.64 M
39.84
4/18/29
109.27
109.27
39.82 M
39.84 M
1/25/27
109.26
109.26
133.39 M
133.46 M
54 53.76
53.78 54
119.16
109.16
228.56 M
10.0
Fairview Ave.
1/4 Line Est from 1/4 Cor Mont at Summit to Mont S.E. Cor. Marshall
80