


John Gaarden's Add.


Underwood Ave

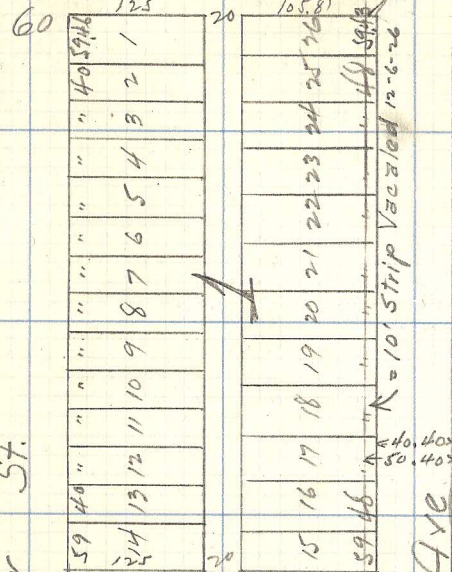

Eleanor St.

Otto Ave

Fredrica Ave

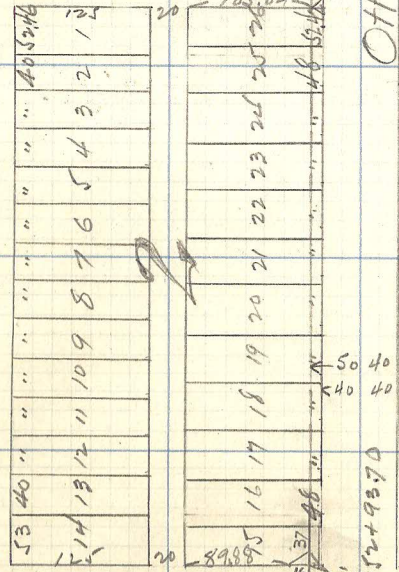

86' Fairview Ave

86'