Copy page 26

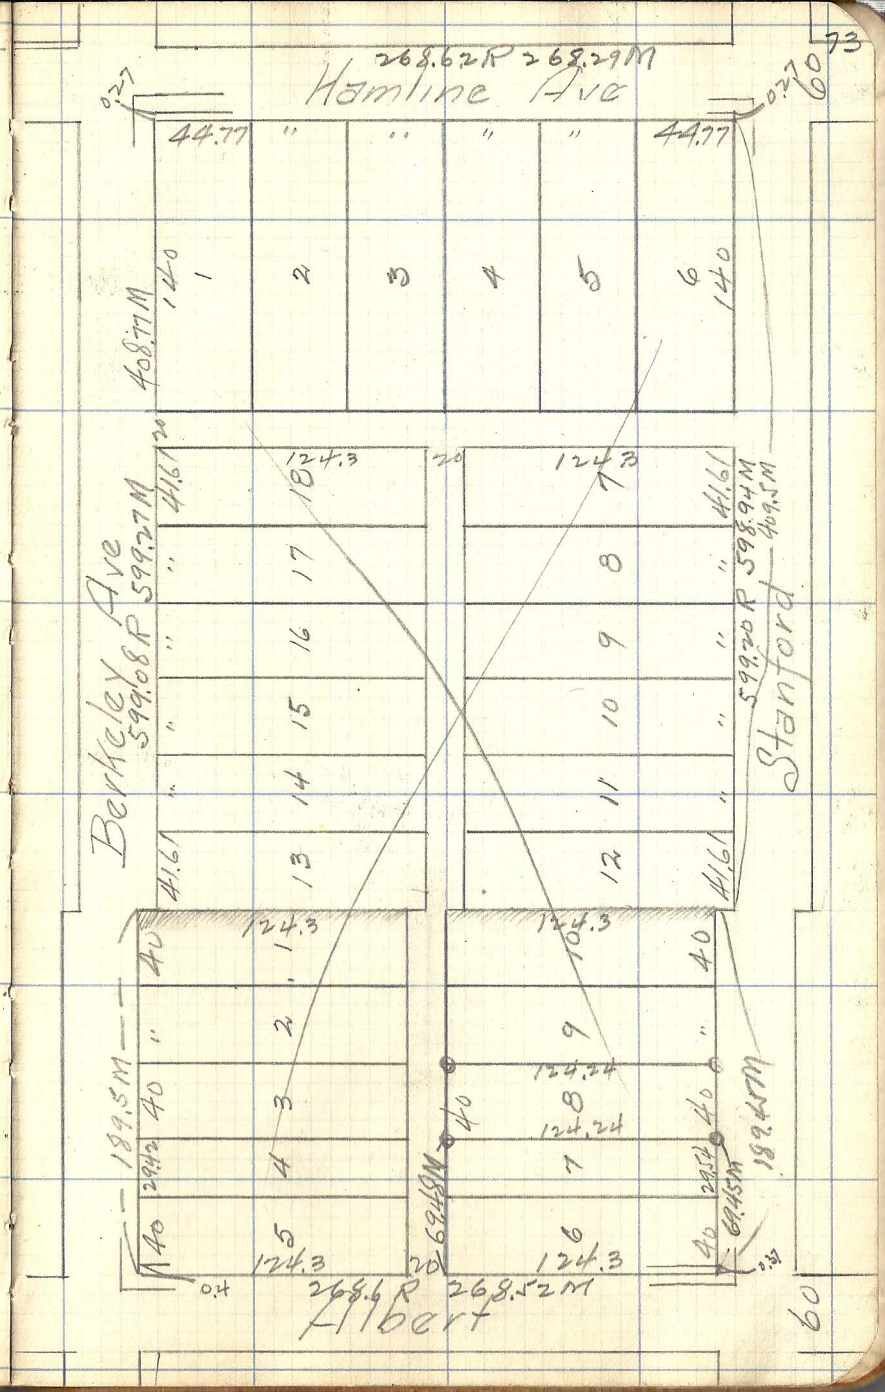

73
60
268.62R 268.29M
Hamline Ave
0.27
44.77
"
"
"
"
44.77
0.27
408.77M
140
1
2
3
4
5
6
140
20
124.3
20
124.3
41.61
18
7
41.61
Berkeley Ave
599.08R 599.27M
"
17
8
"
599.20R 598.94M
409.5M
"
16
9
"
"
15
10
"
"
14
11
"
41.61
13
12
41.61
Stanford
124.3
124.3
40
1
10
40
"
2
9
"
124.24
40
3
8
40
124.24
40
189.5M
29.42
4
7
29.54
69.48M
69.45M
189.45M
40
5
6
40
124.3
20
124.3
0.4
268.6R 268.52M
Albert
0.37
60