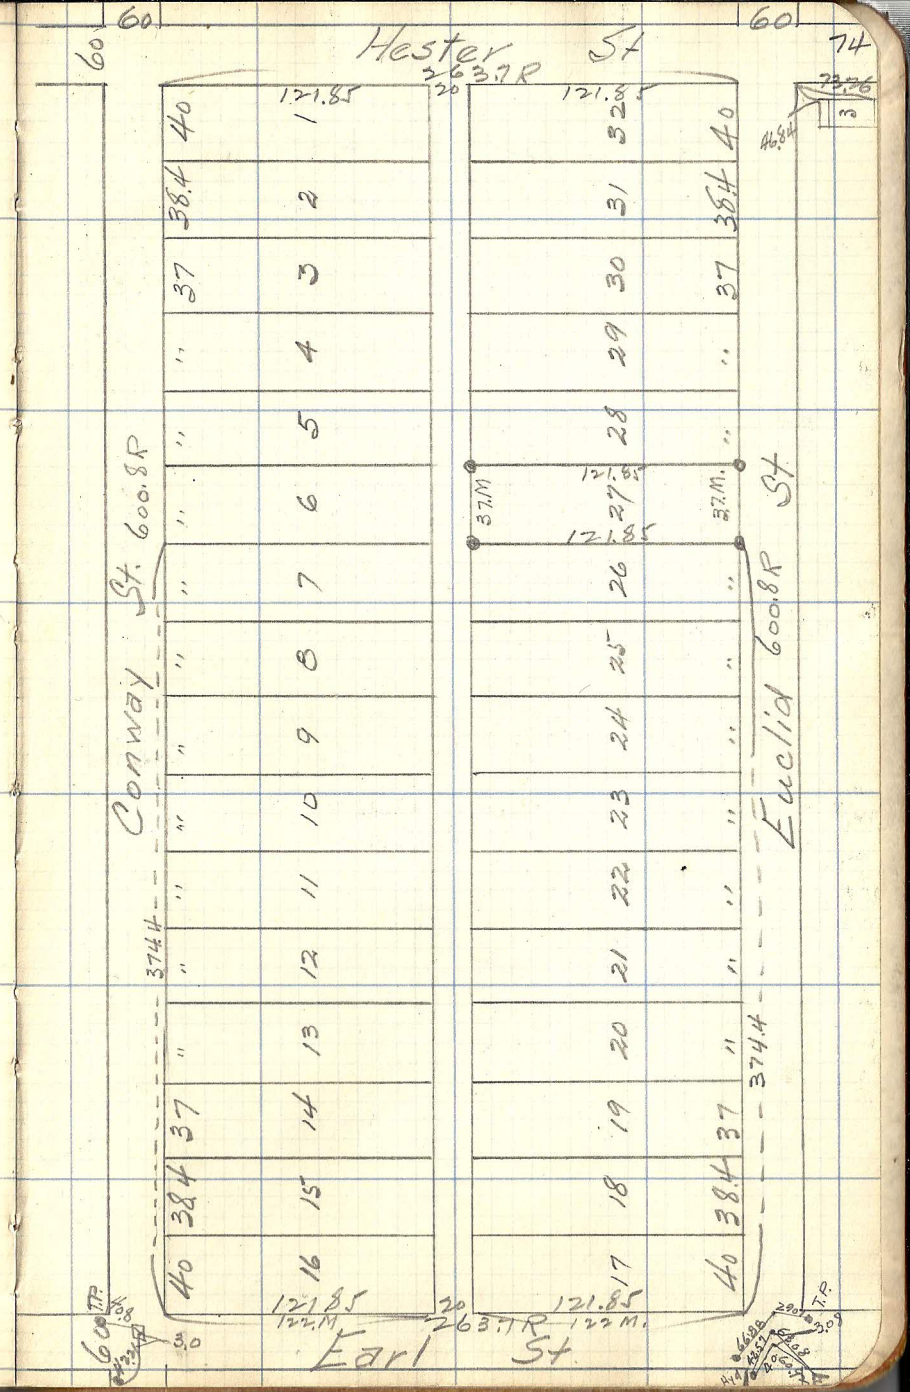Lot 27 Blk 1 H.F. Schwabe's Add.