


Lot 24 & 1/2 25 Bk. 7
Phalen Heights Park

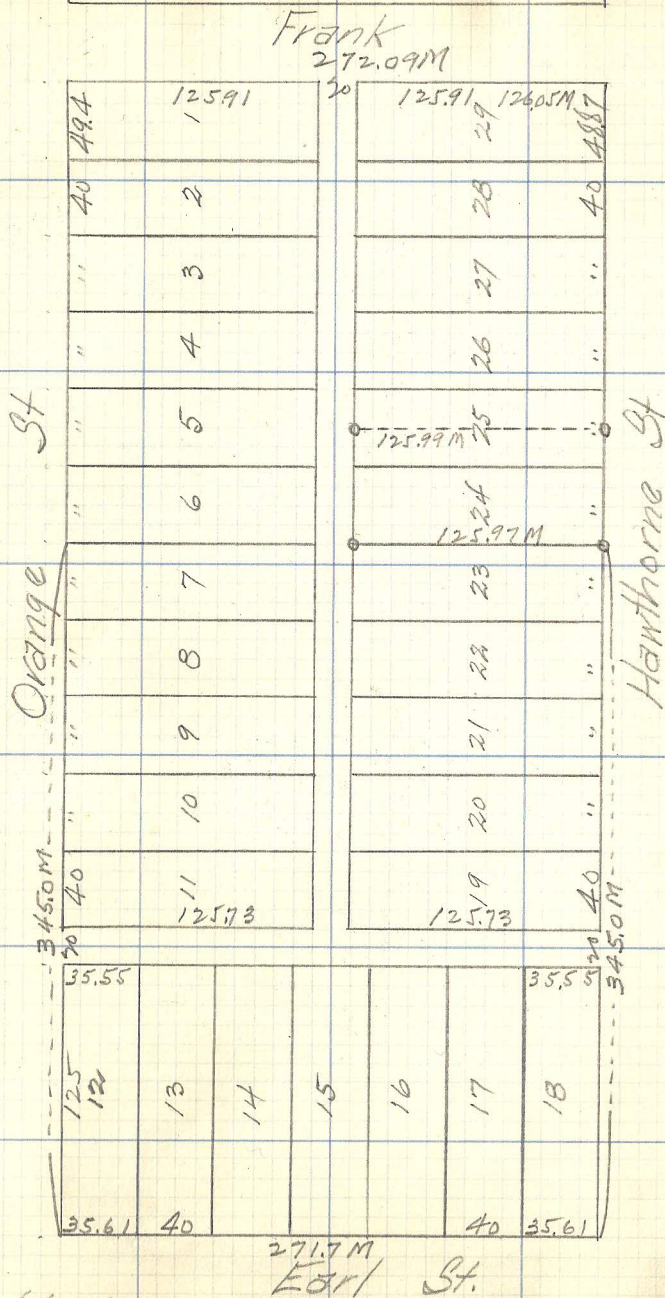

Mont of Maryland,
Ties. in book 2 Page 46