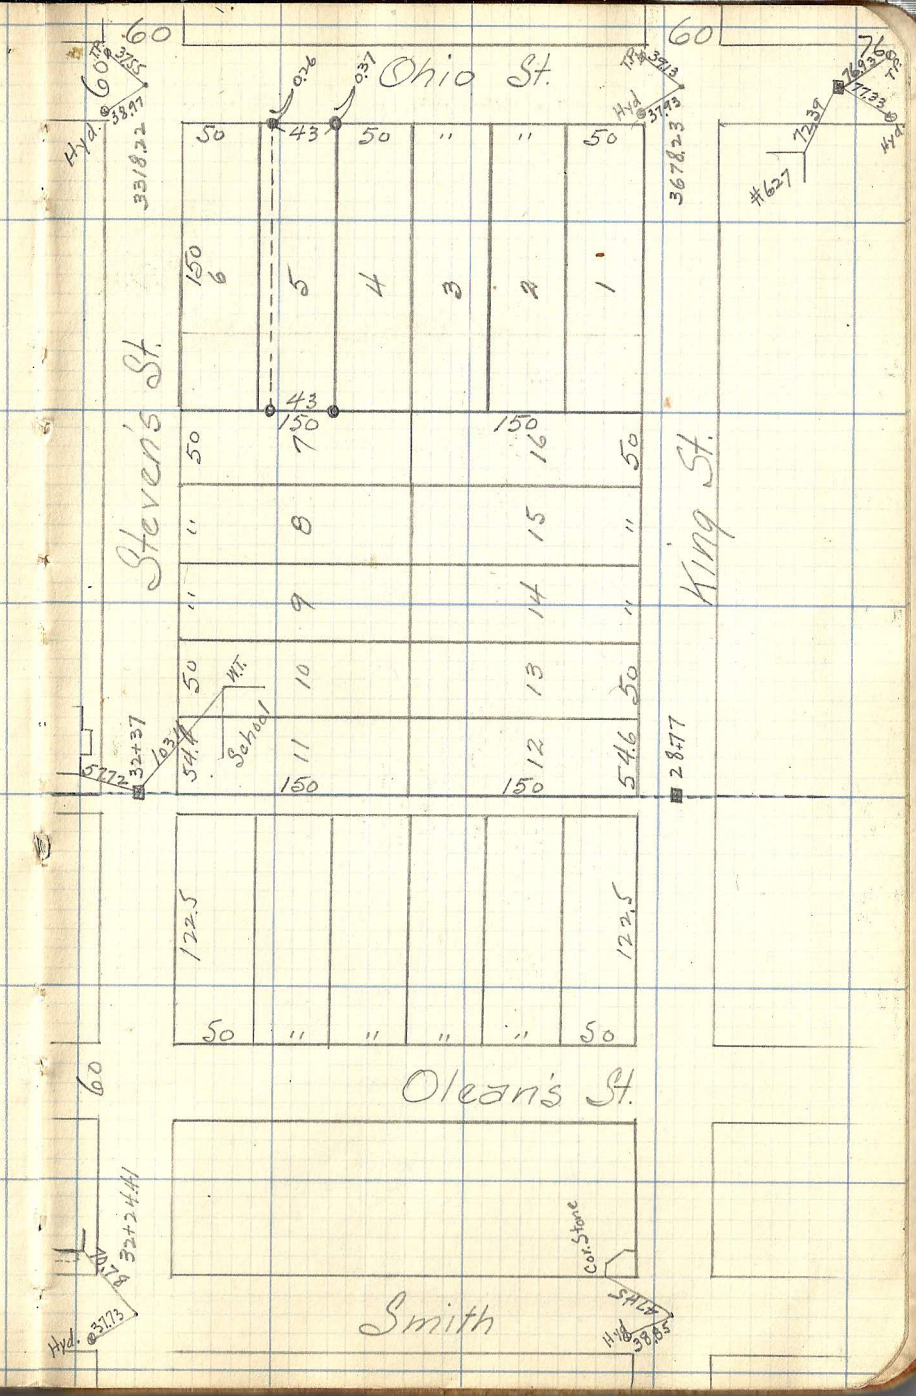
Ohio St.
Stevens St.
King St.
Olean's St.
Smith
60
43
50
150
0.36
0.37
Hyd.
W.T.
School
cor. Stone
#627