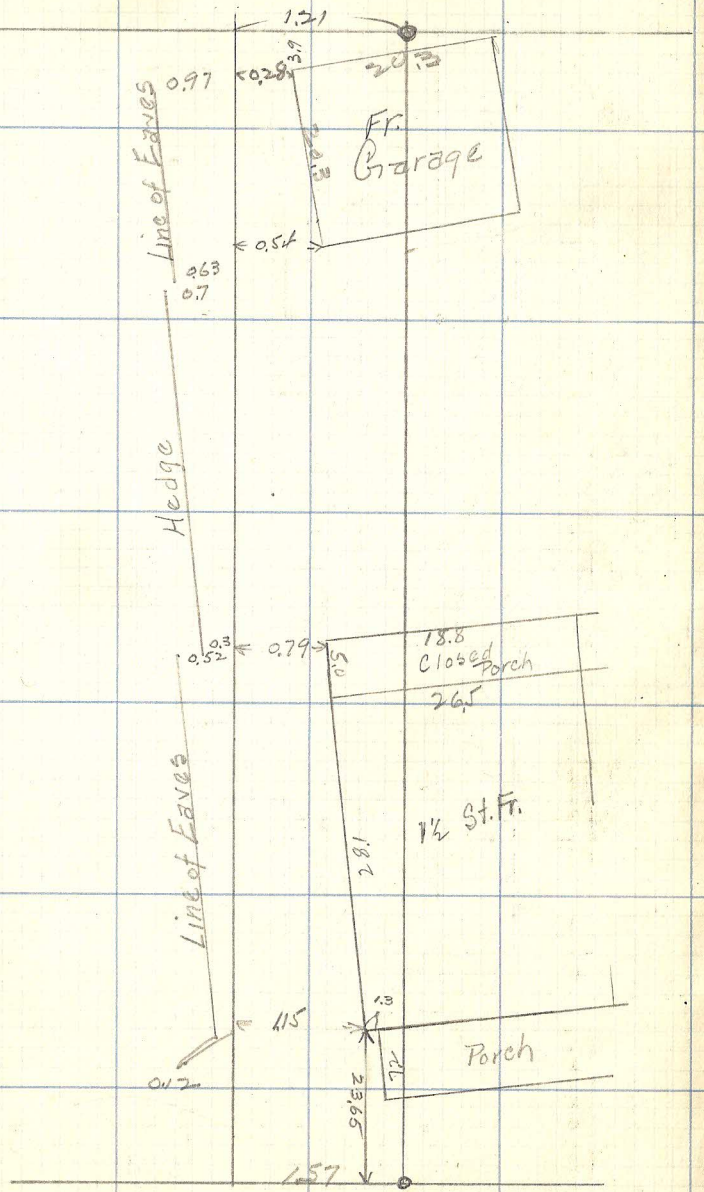
1.21
3.9
20.2
0.97
0.28
Fr.
Garage
0.54
0.63
0.7
Line of Eaves
Hedge
0.3
0.52
0.79
18.8
Closed Porch
26.5
1½ St. Fr.
28.1
Line of Eaves
1.15
1.3
Porch
27
23.65
1.57

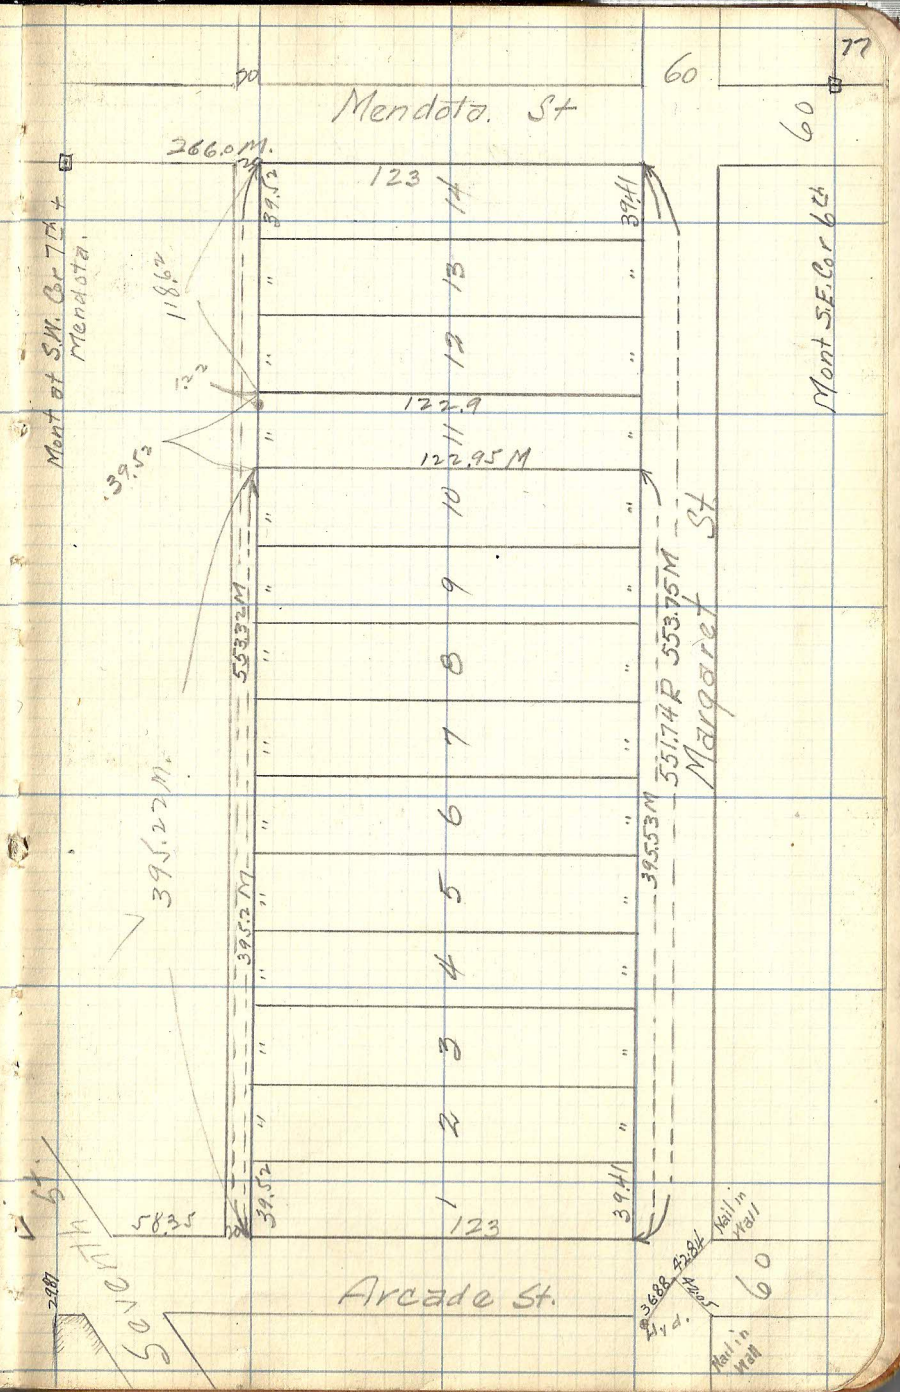
77
60
Mendota. St
266.0 M.
123
14
13
12
11
10
9
8
7
6
5
4
3
2
1
39.52
39.41
118.6
122.9
122.95 M
Mont at S.W. Cor 7th
Mendota.
39.53
59.32 M
39.52 M.
39.53 M
551.74 P 553.75 M
Margaret St
Mont S.E. Cor 6th
58.35
Arcade St.
Nail in Yrd
Nail in Wall