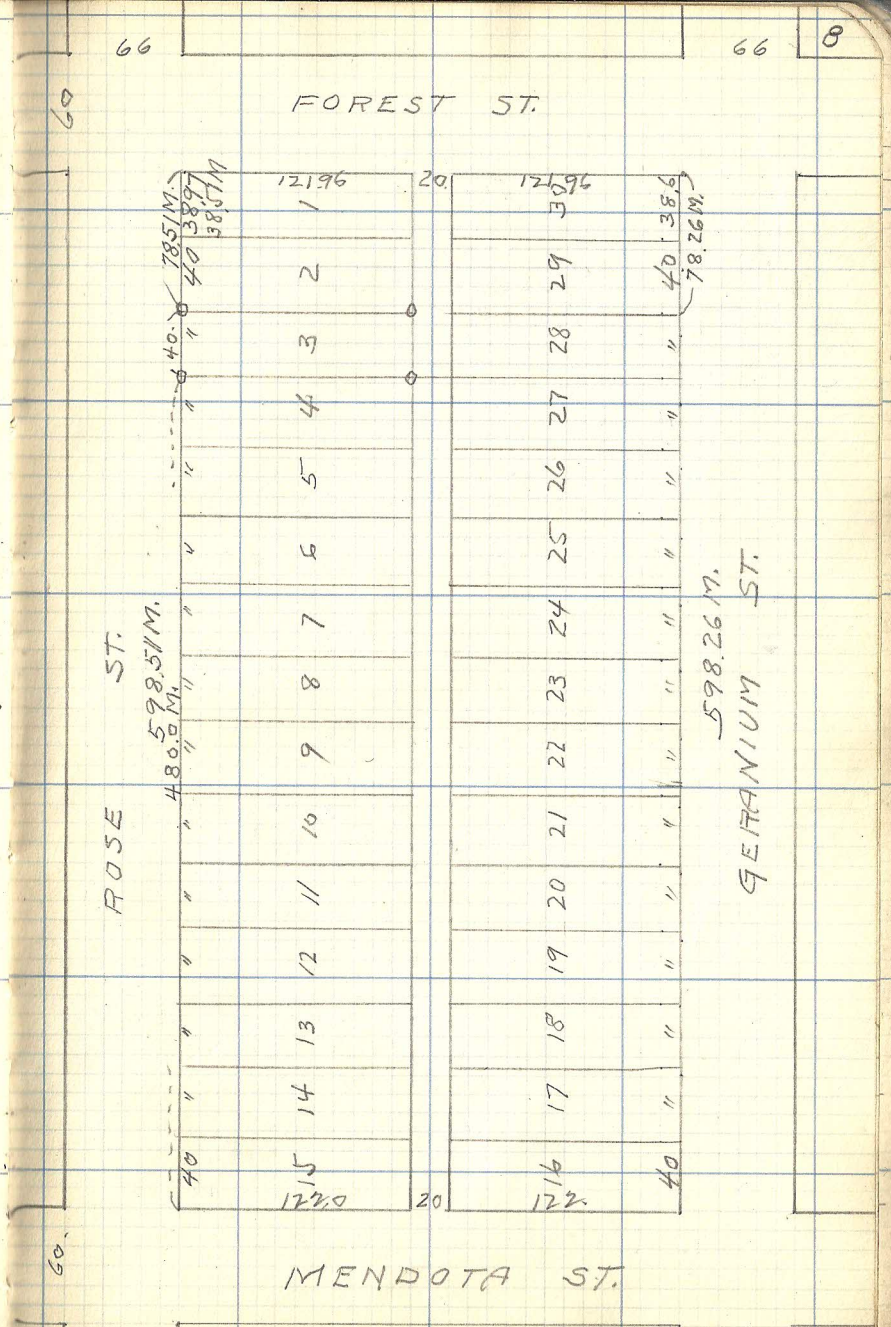EASTVILLE HEIGHTS
LOT 3 BLK. 7