Govt. Lot 3
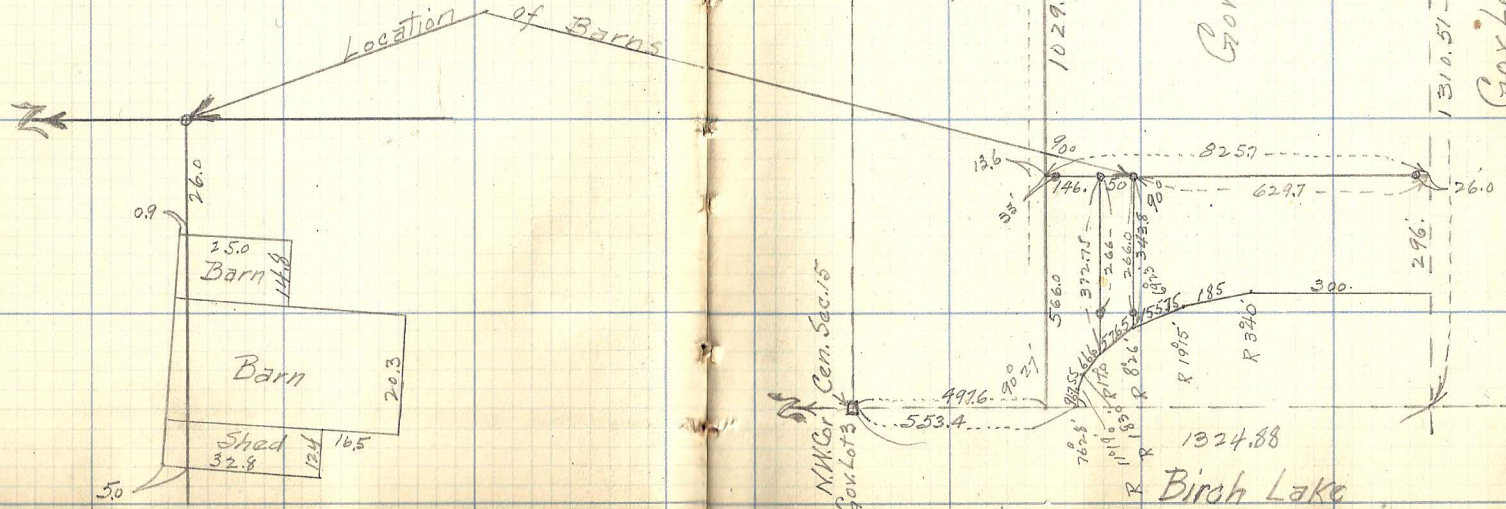
Sec. 15-30-22