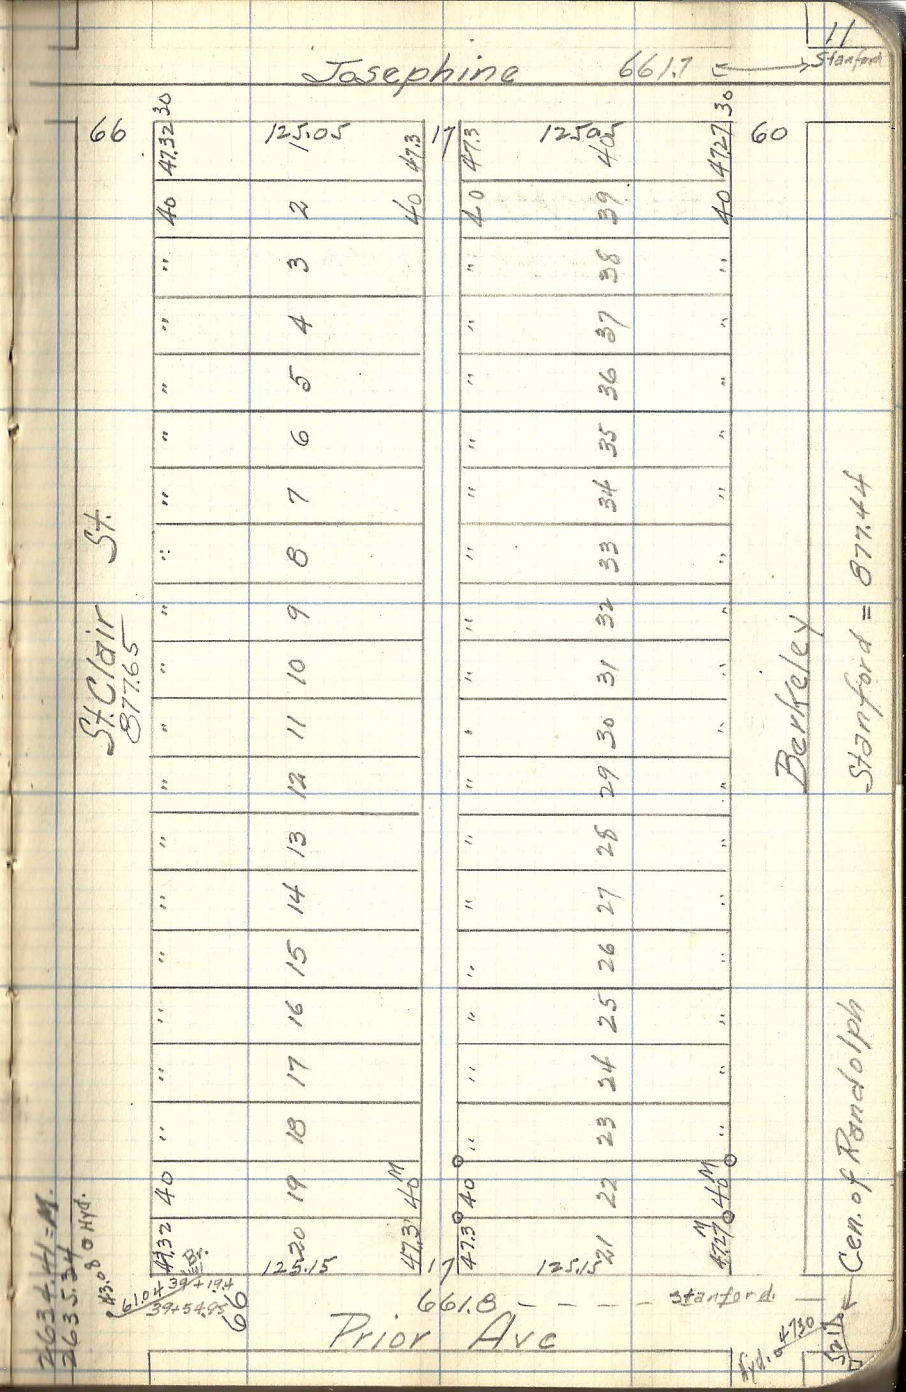Lot 22 Blk. 1
Auditors Sub. No 58