


Sec. 11 - T. 30 - R. 23

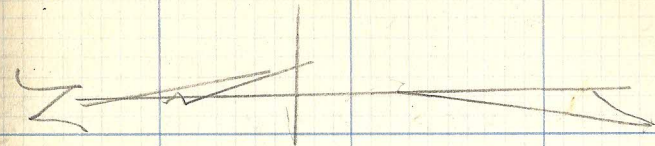


N 1/4 Cor. Sec. 11

County Road I

1335.0

North Line Sec. 11

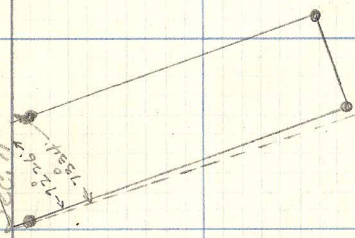

Lexington Area

NW Cor. Sec. 11 T. 30 - R. 23