W ½ of N.W.¼ of N.E.¼ of S.E.¼ Sec. 16-28-23
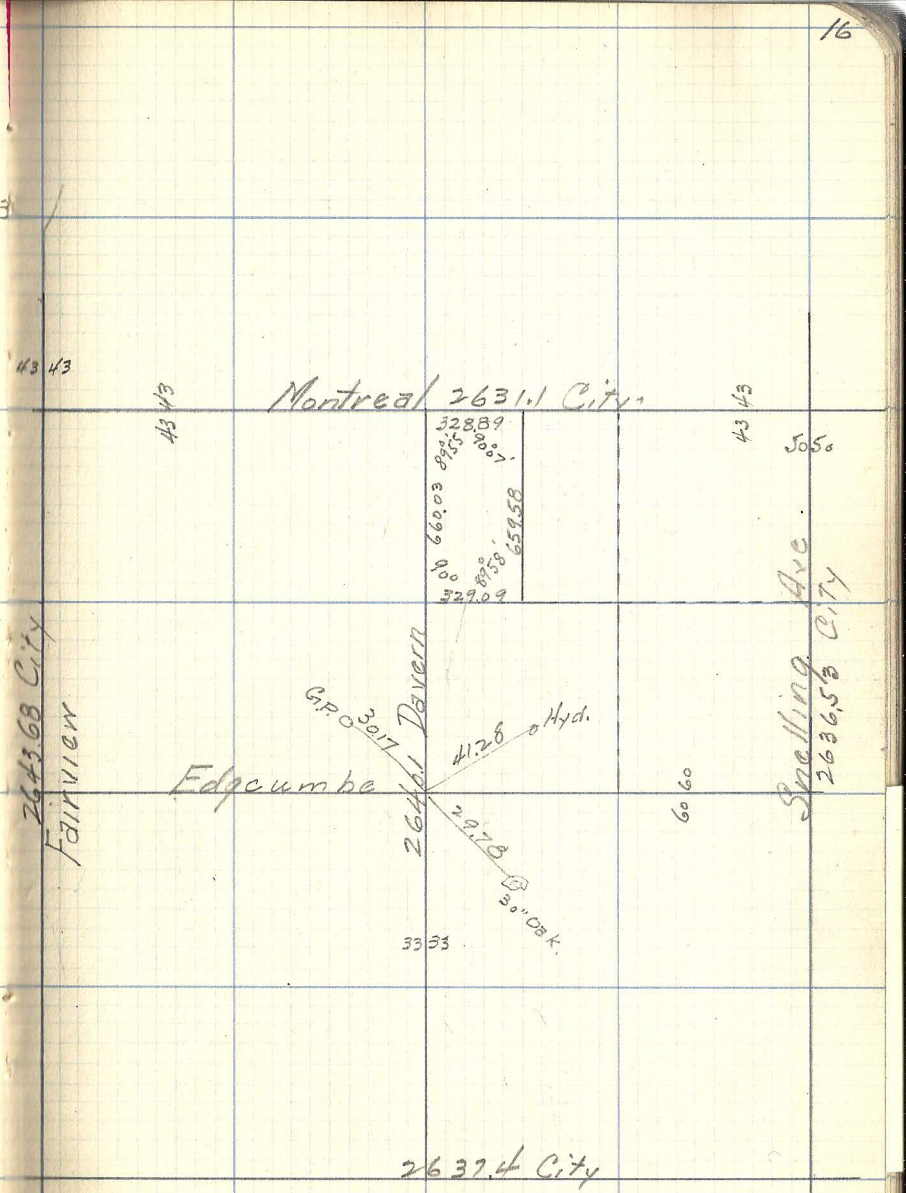
Sec. 16 T. 28 R. 23