


Hawthorne

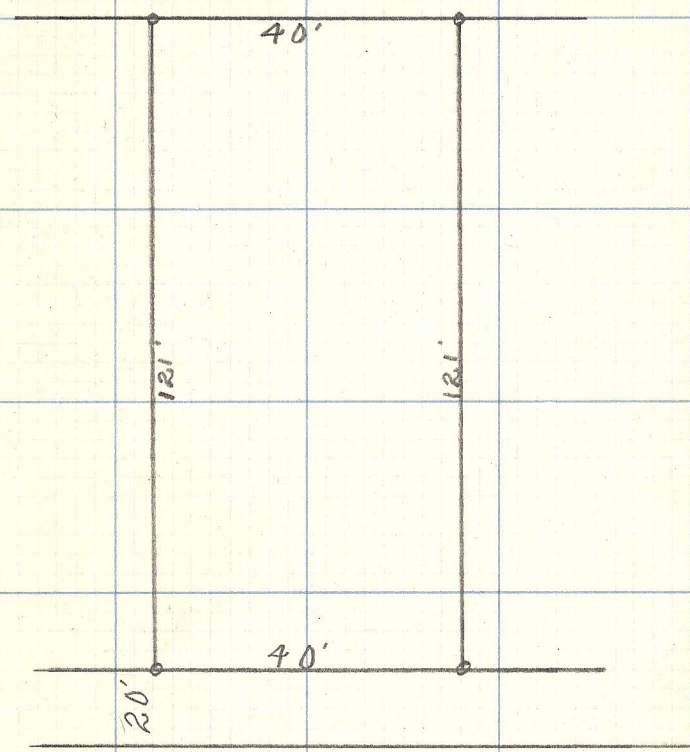

Lot 2 B1K 8  
Phalen Heights Park  
June 28, - 26