Mac. Col. Add.

09
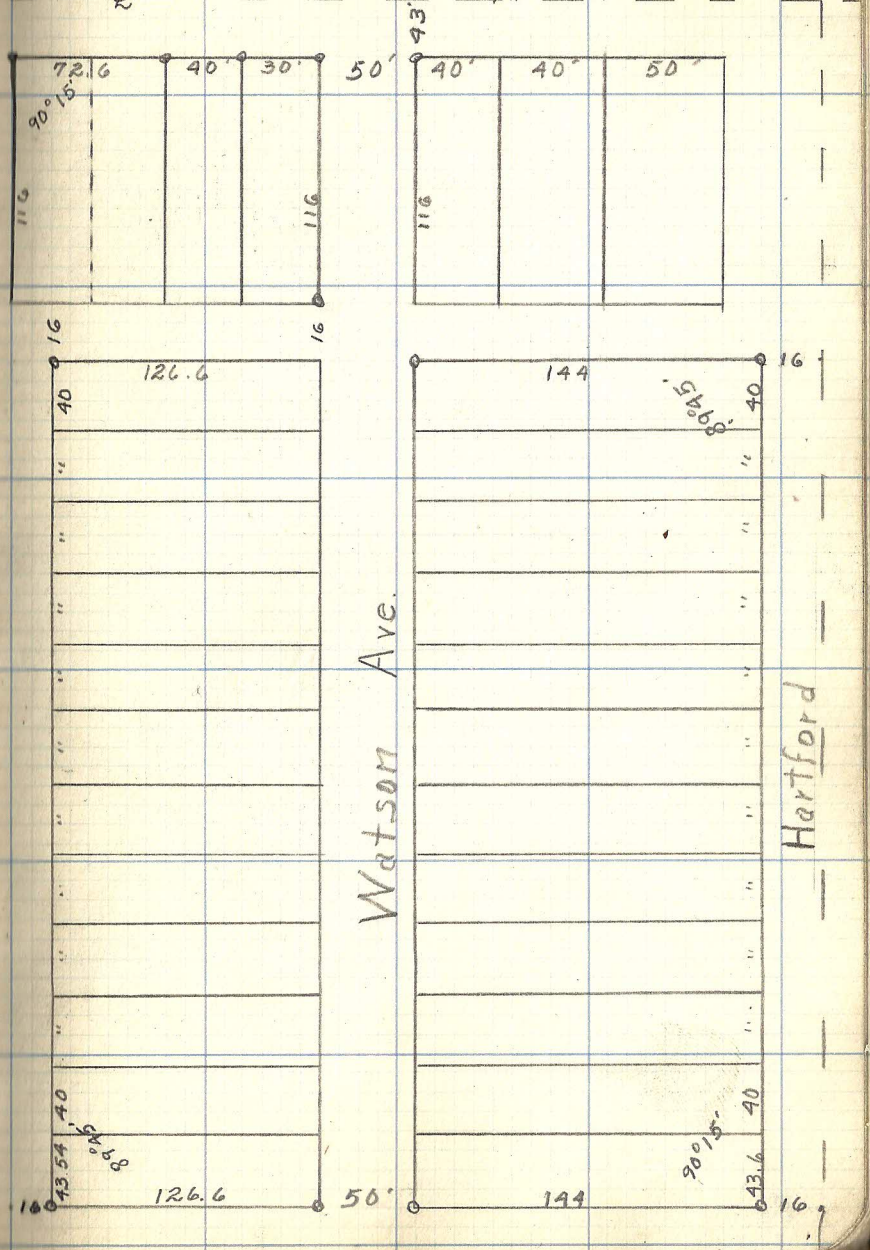
& — — — — Fairview — — —