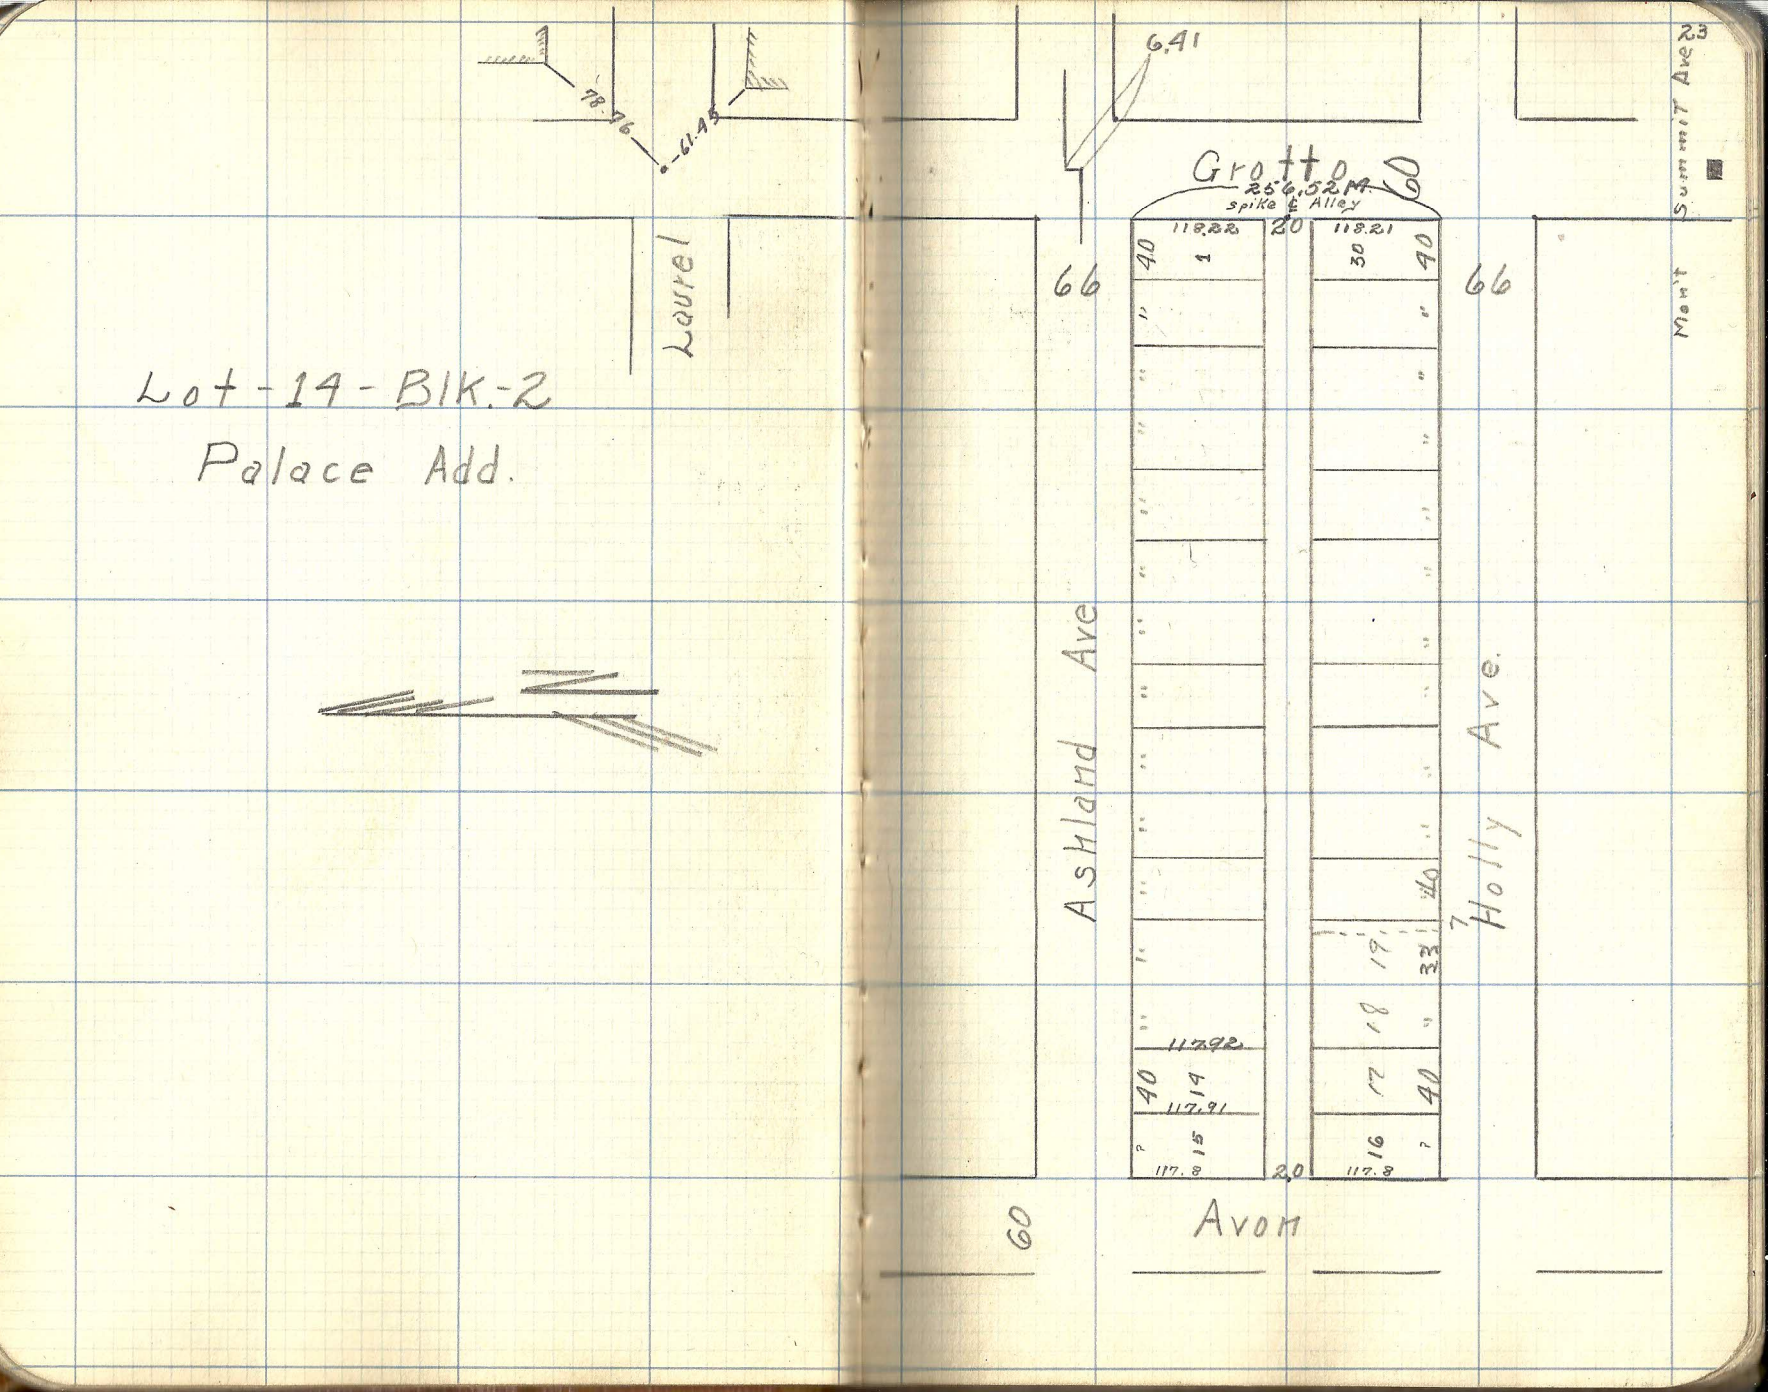
Lot - 14 - Blk. 2
Palace Add.
Laurel
78.76
61.45
6.41
Grotto
256.52 M
spike & Alley
60
20
66
66
Ashland Ave
Holly Ave.
Summit Ave
Main
118.22
118.21
40
30
1
33
19
18
17
16
15
14
117.92
117.91
117.8
117.8
2.0
60
Avon
23