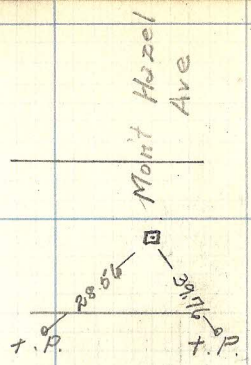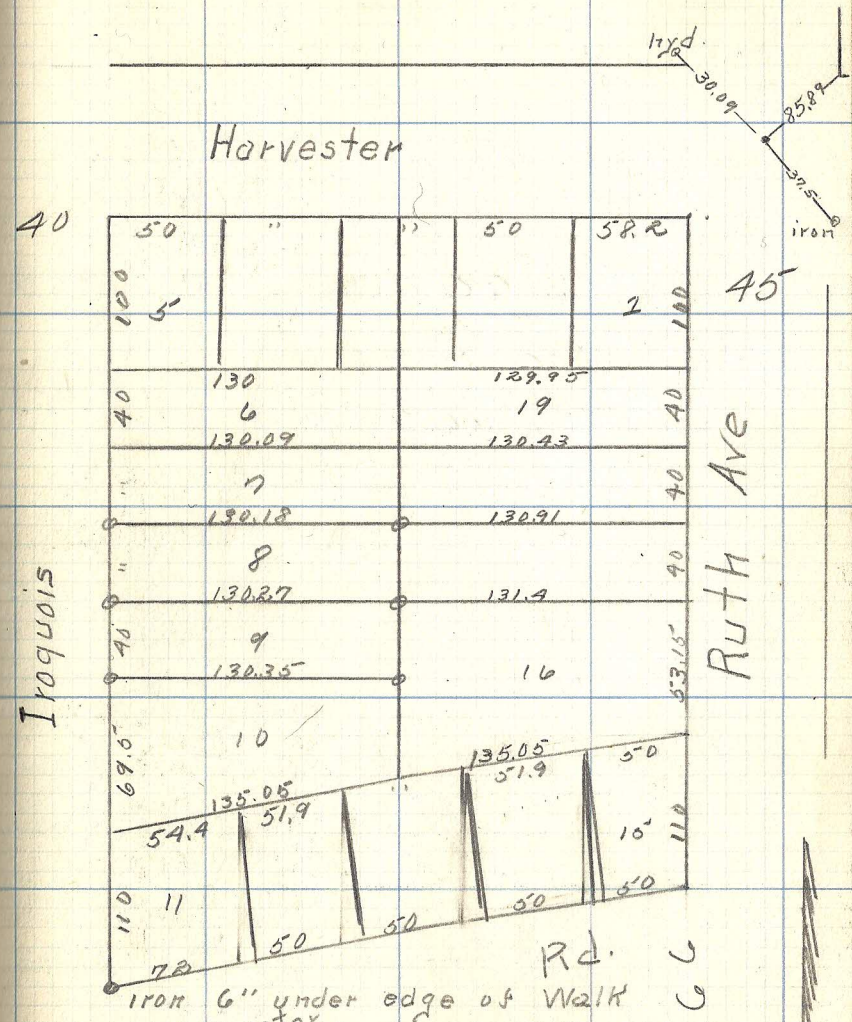Lots 8 & 9
Blk 6
Beaver Lake Heights