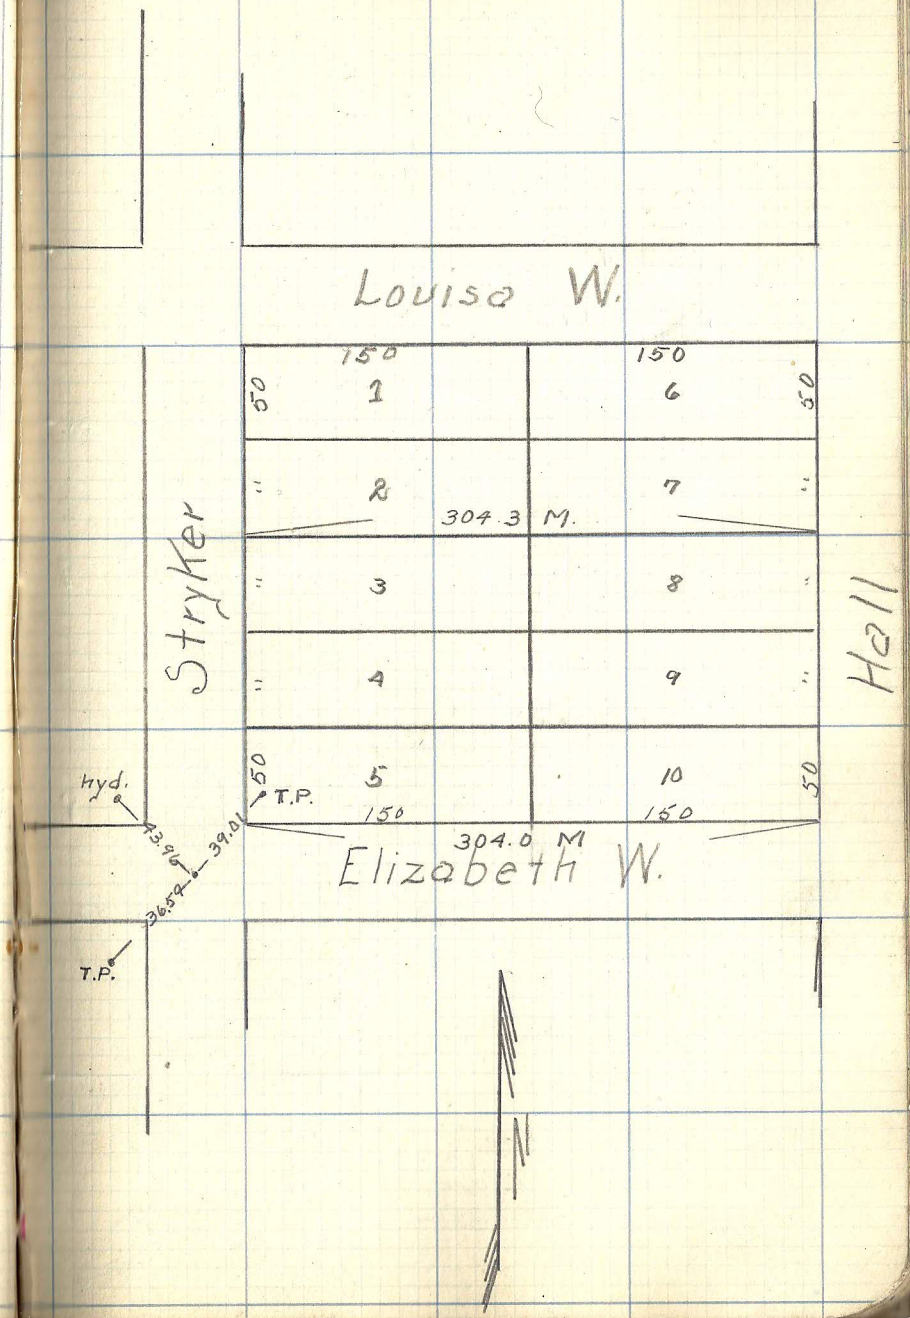Lots 3-4-5
BlK 116
St Paul Proper