
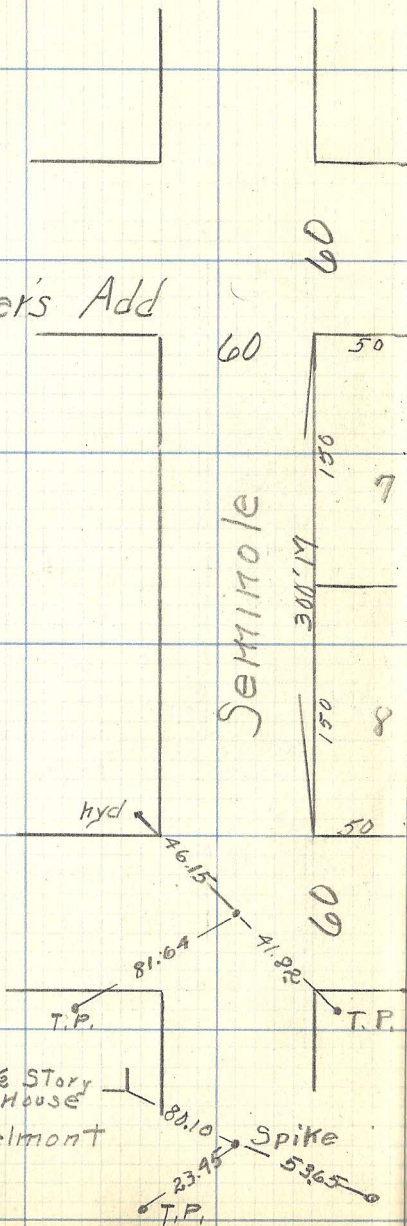


Lot 11  
 BIK 98  
 Banning & Oliver's Add

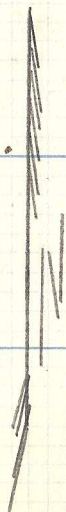


SEMI MOLE

Mont approx 111.3 N. of & Baker

31 T.P.  
 90.68  
 45.87

Brick Pier

Page

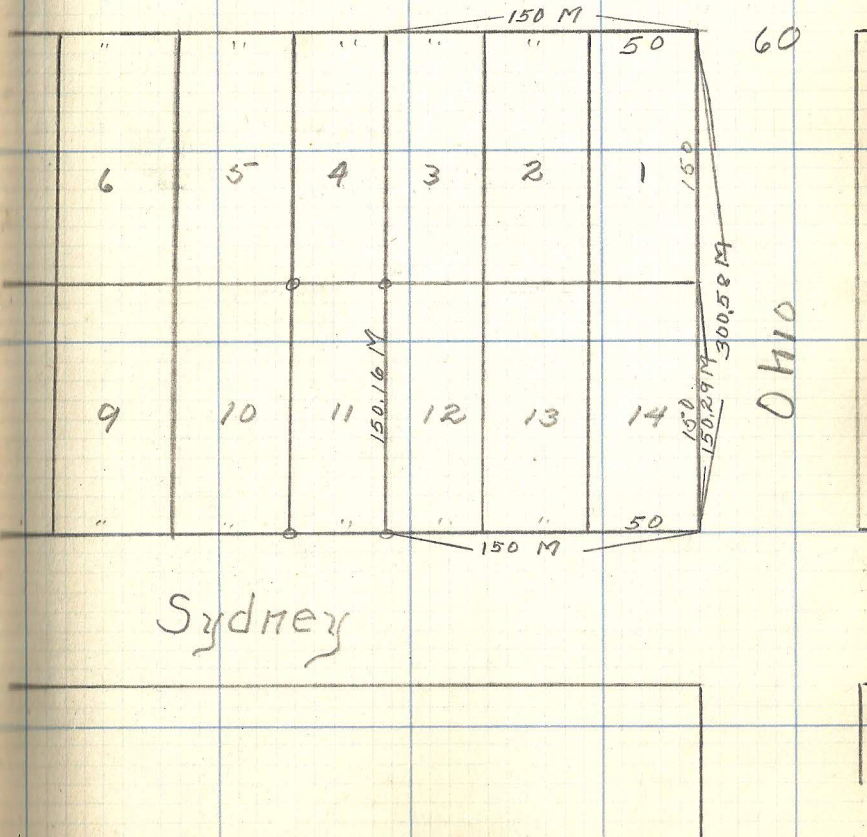

3 nails in oak