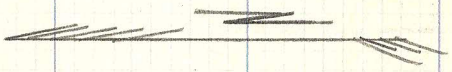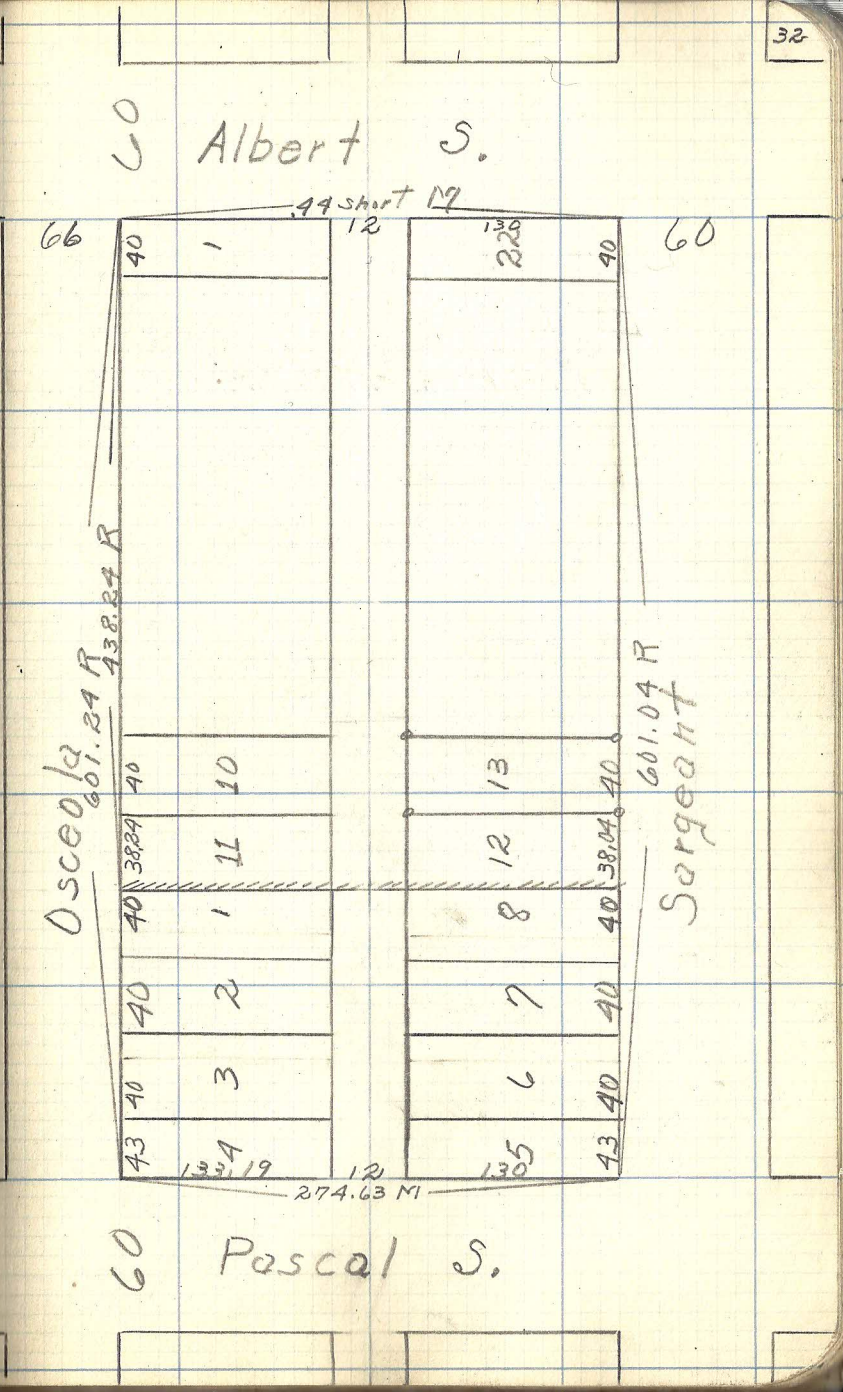Lot 13
Blk 2
Sargent's Add