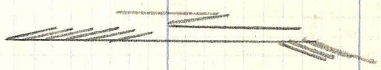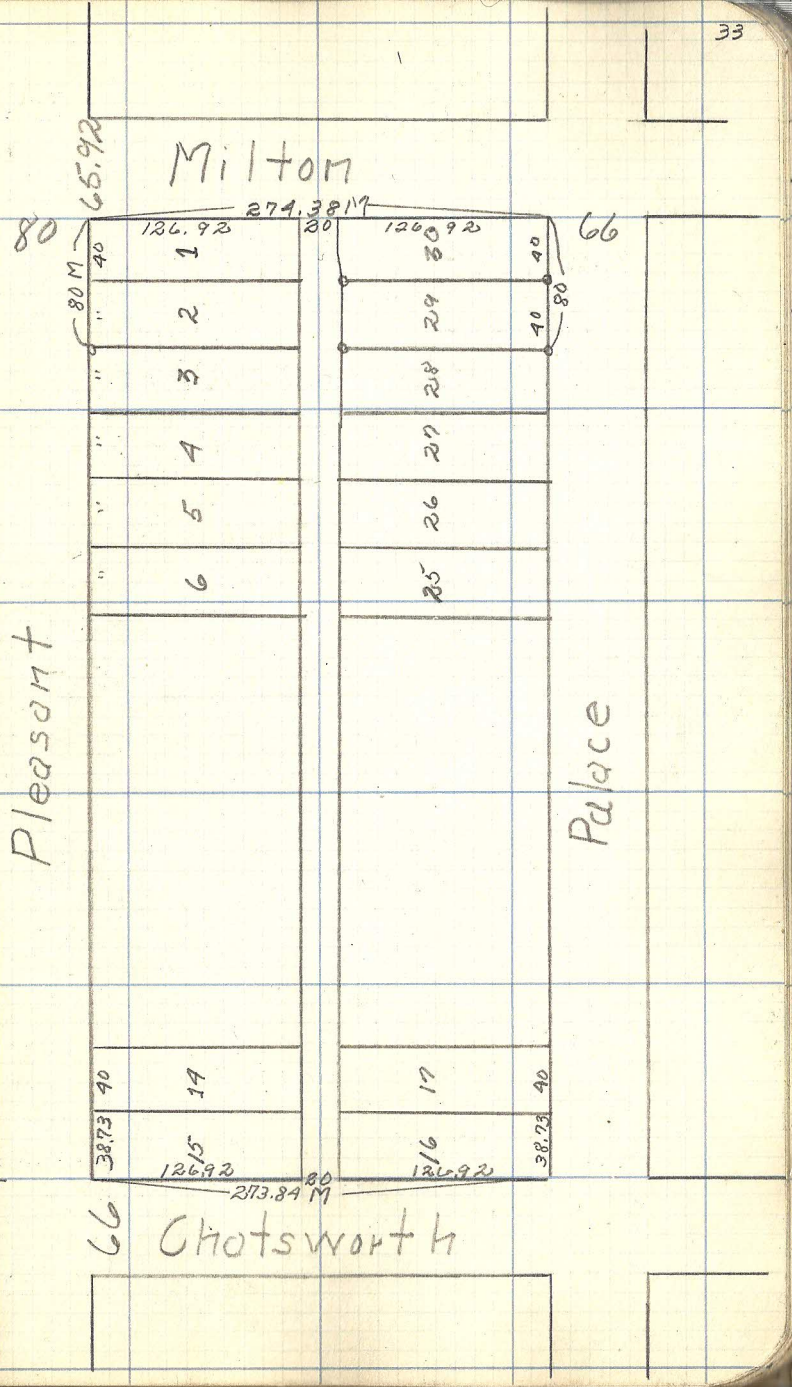Lot 29
Blk 2
Michel & Robertson's
Add