Lot 6
Blk 1
Rose Hill Add
Sec-17-29-23
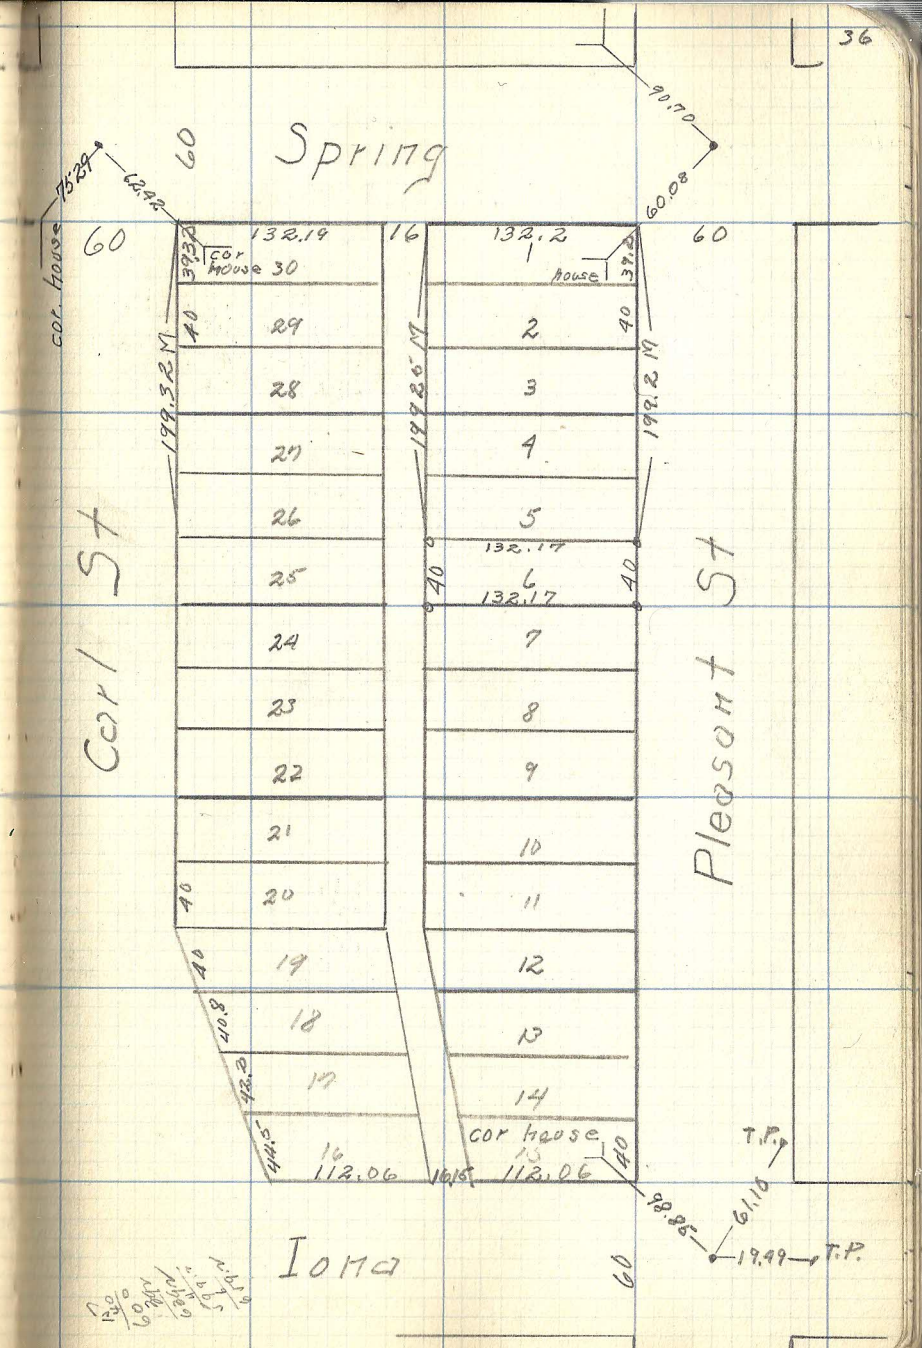
3-21-28