



Lex AT Blair

Lot 1

American Bldrs Plat
No. 2

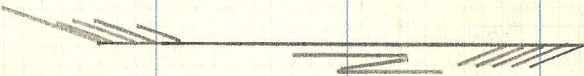

Lexington Ave.

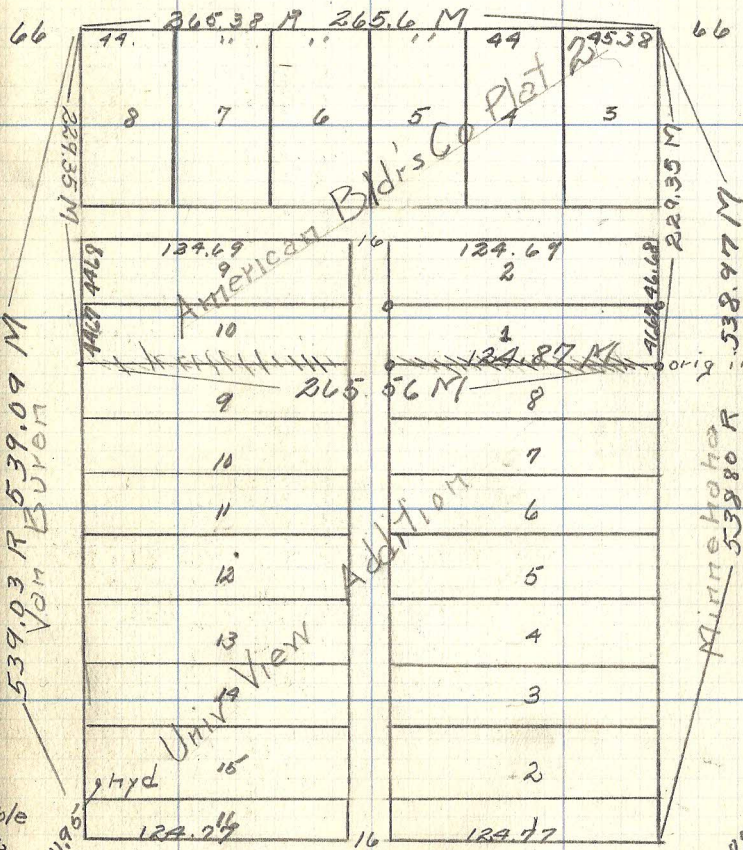

Pole
539
41.90

Hyd
3887
97.98