Lots 19-20
West St Paul Real
Estate And Improvement
Syndicate No 1
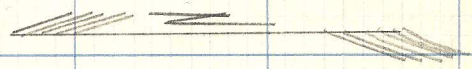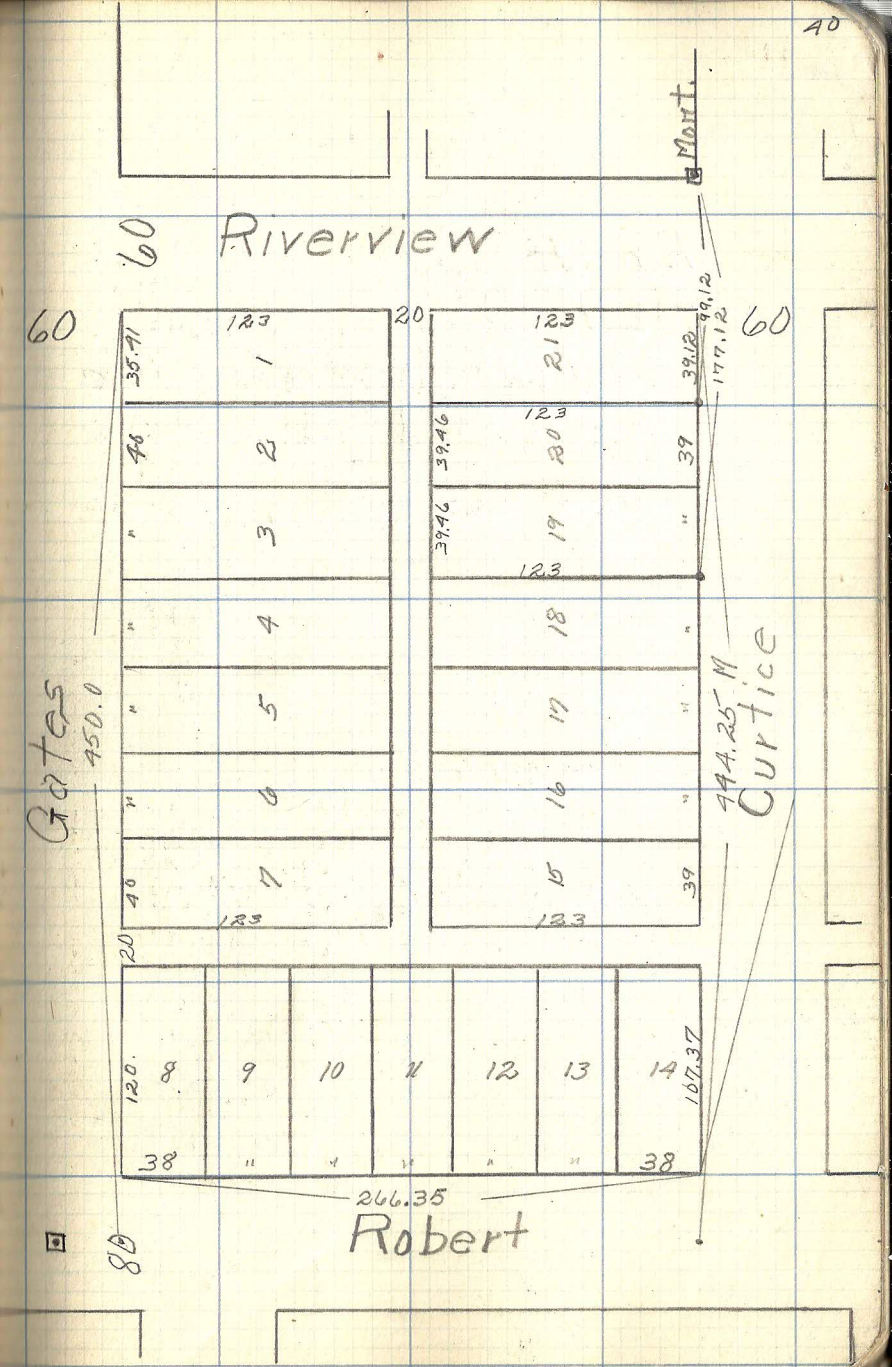
July 13, 1928