


Lot 8
Blk 3
Mid Heights Add

June 12, 1938

60 G.N.R.R. Co.

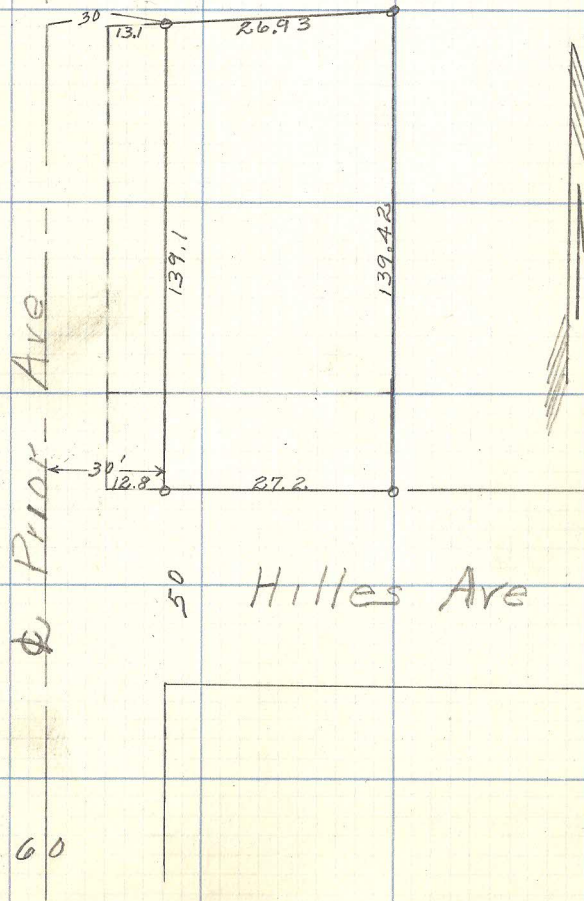

60