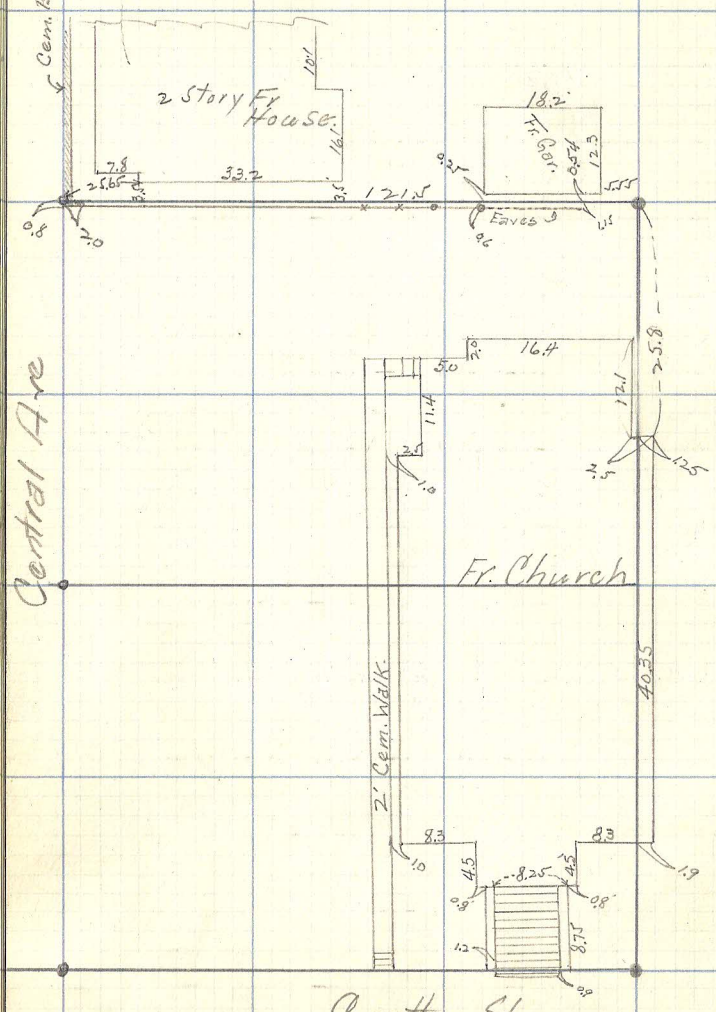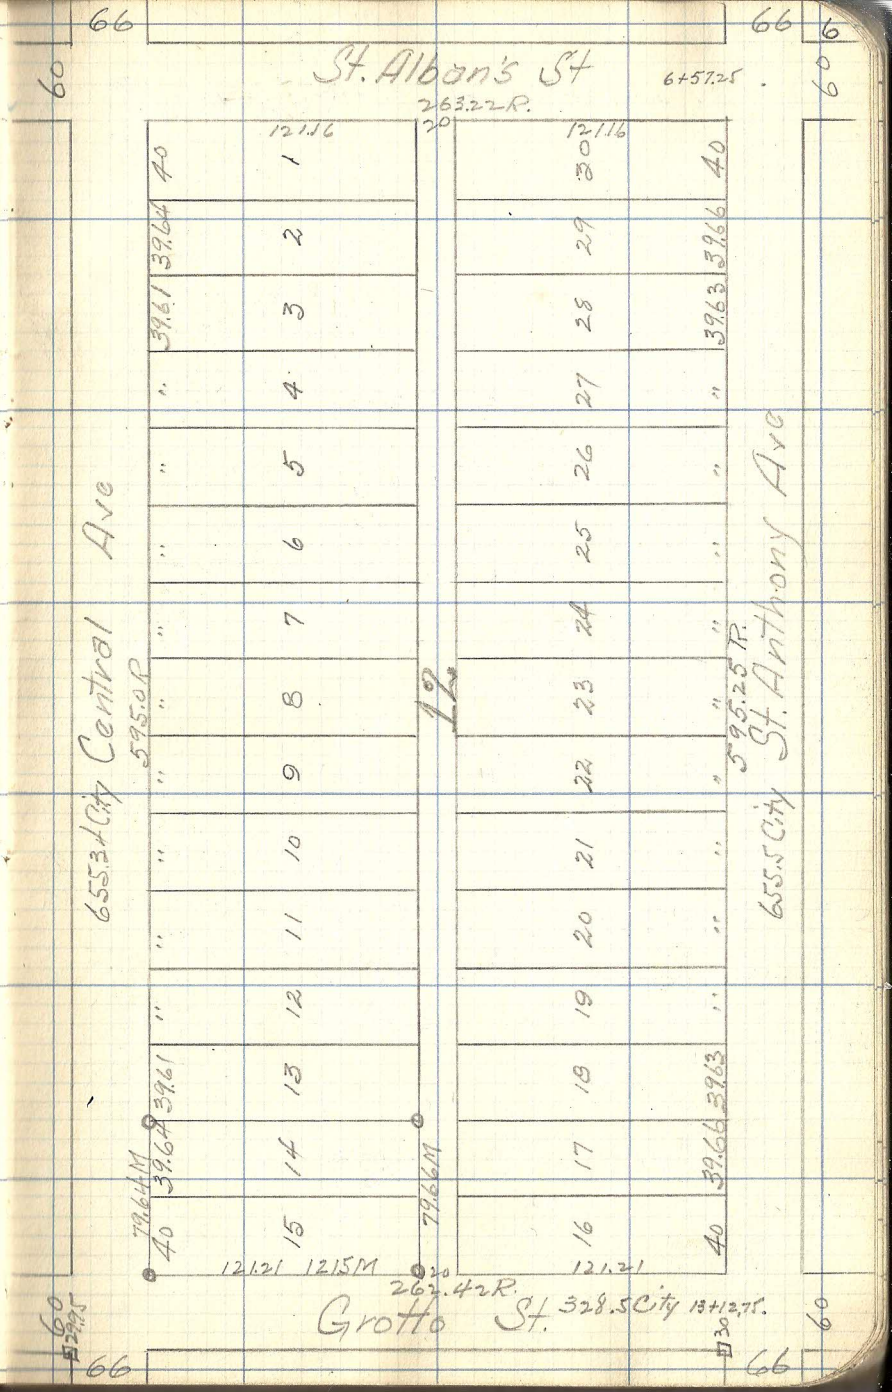Lots 14+15 Blk 12 Butterfield Syndicate #1