


14-74  
 For Sisters of The Good Shepherd  
 formerly part of Service College, Block 68

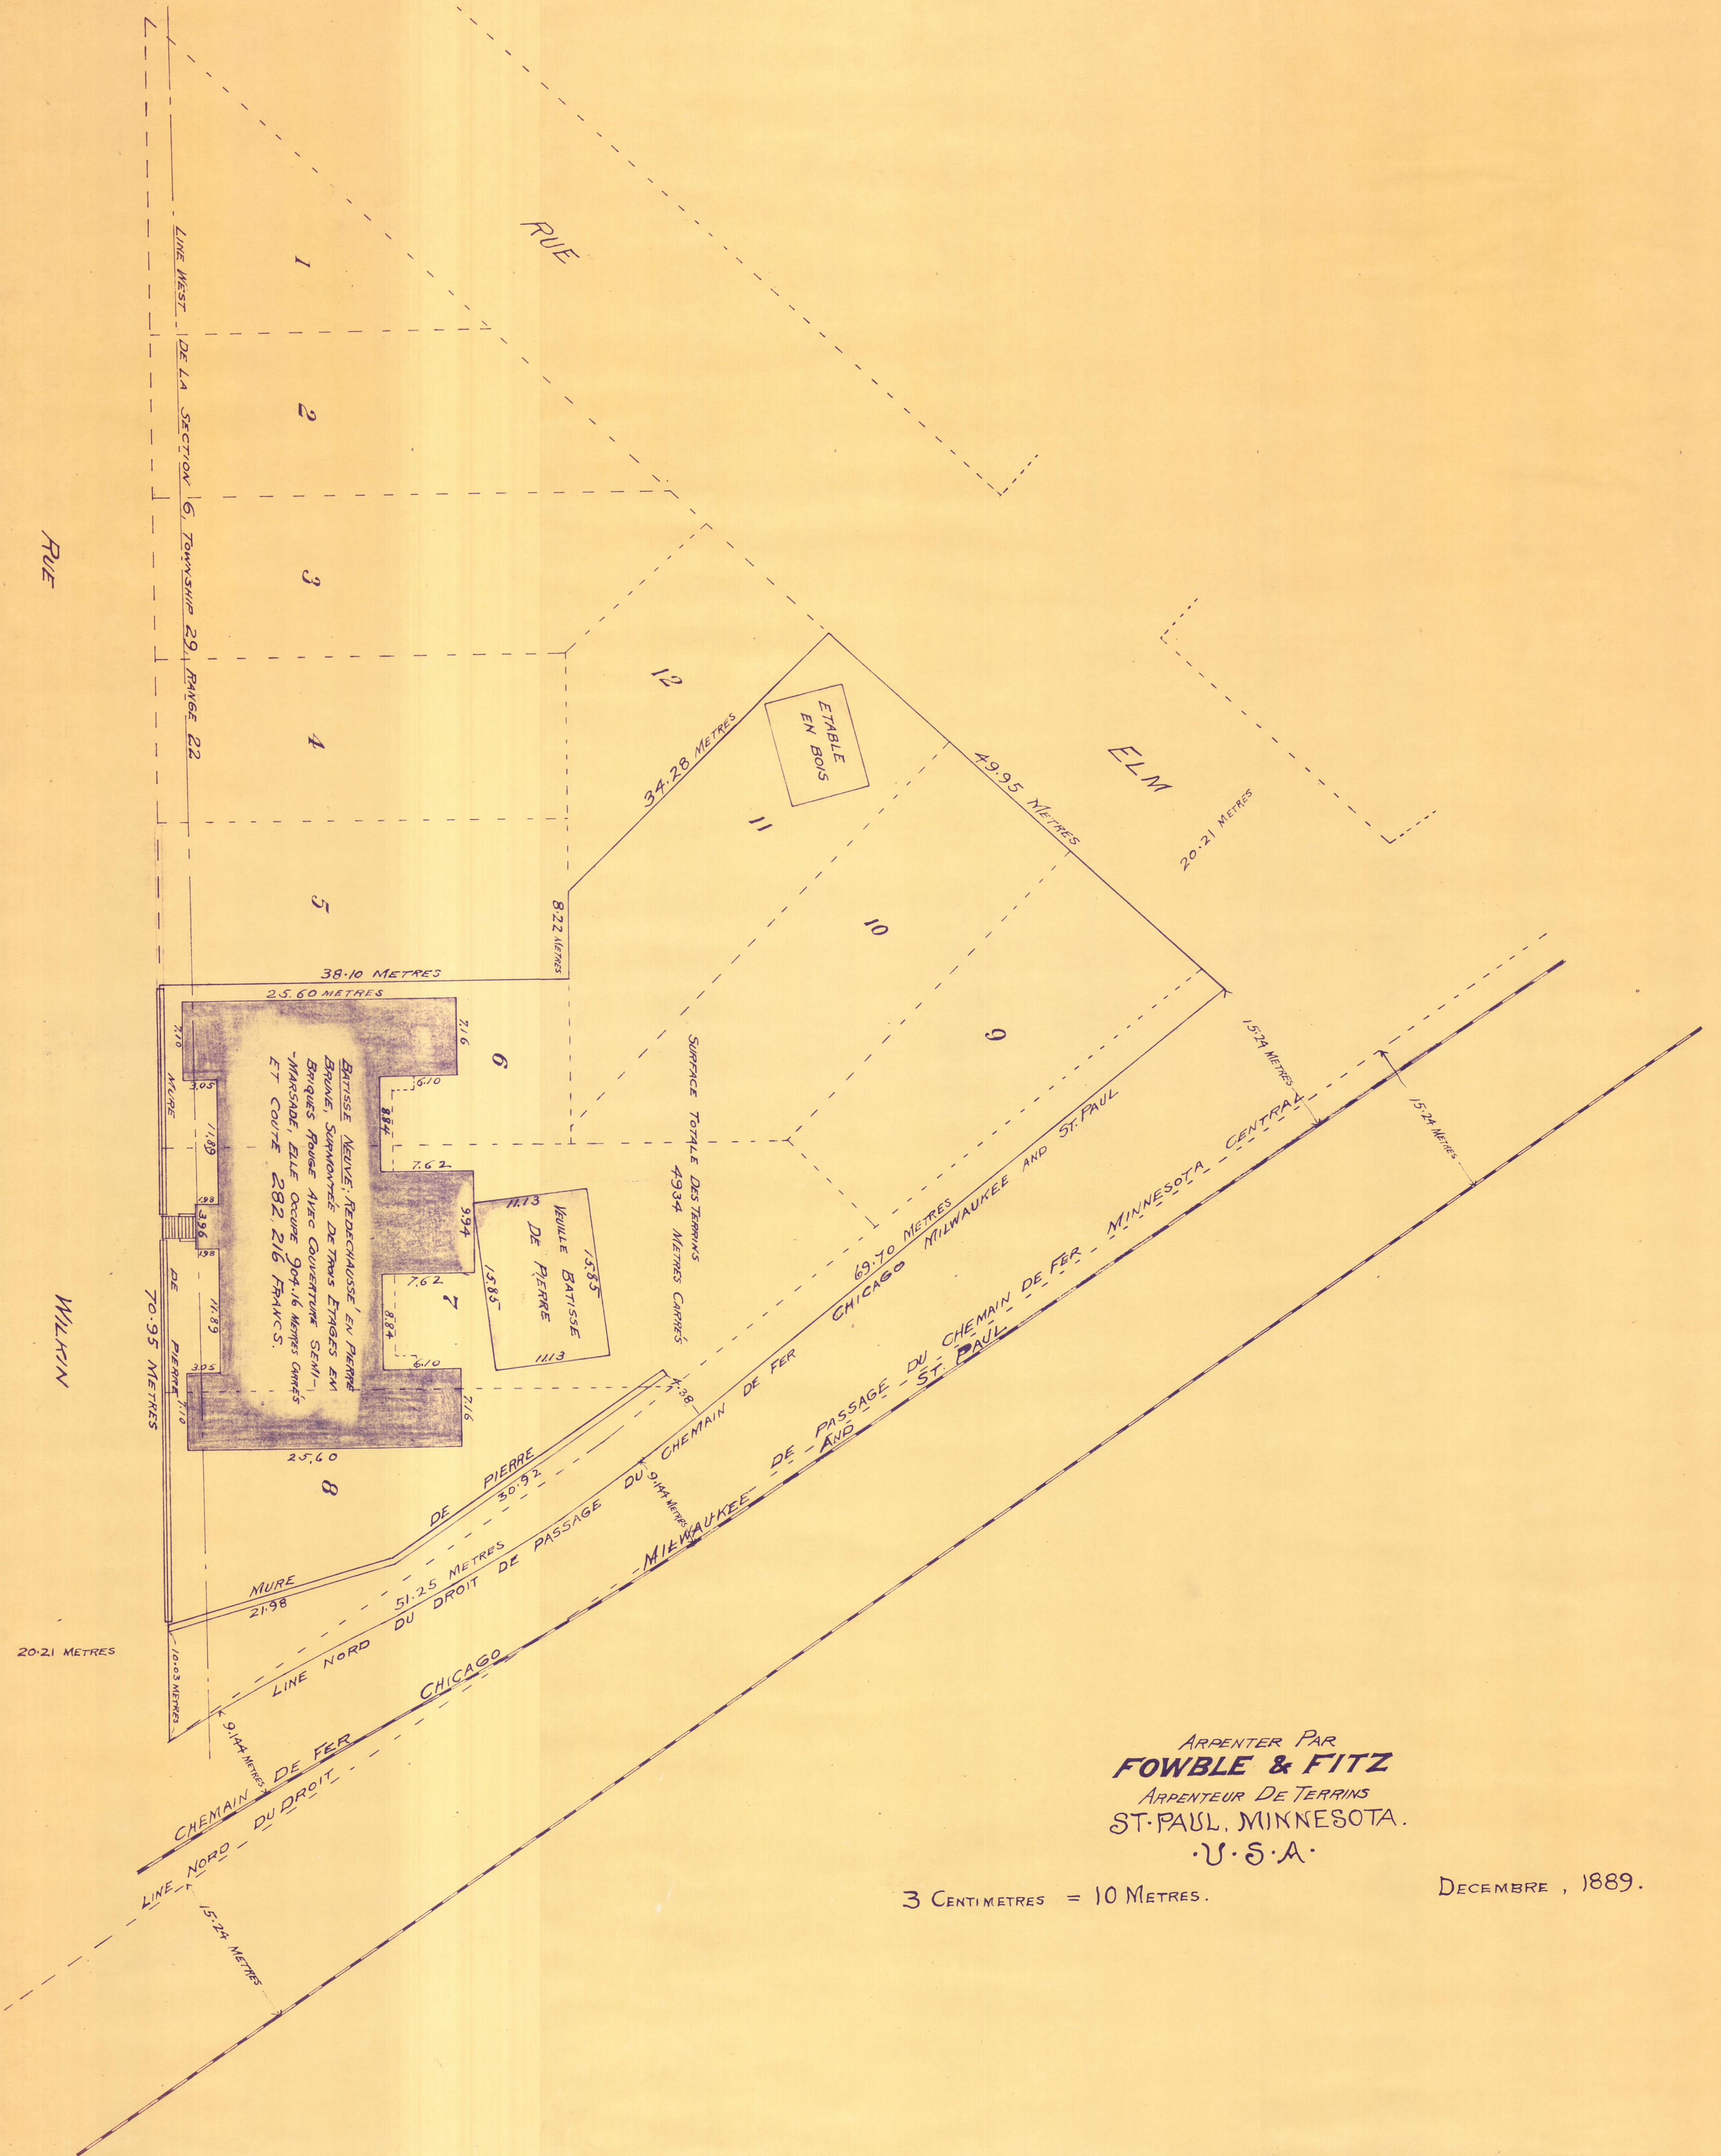

ARPEINTER PAR  
**FOWBLE & FITZ**  
 ARPEITEUR DE TERRINS  
 ST. PAUL, MINNESOTA.  
 U.S.A.

3 CENTIMETRES = 10 METRES.

DECEMBRE, 1889.