


PROP. SOLD TO  
RAMSEY CO.  
NSP DEED# 6295

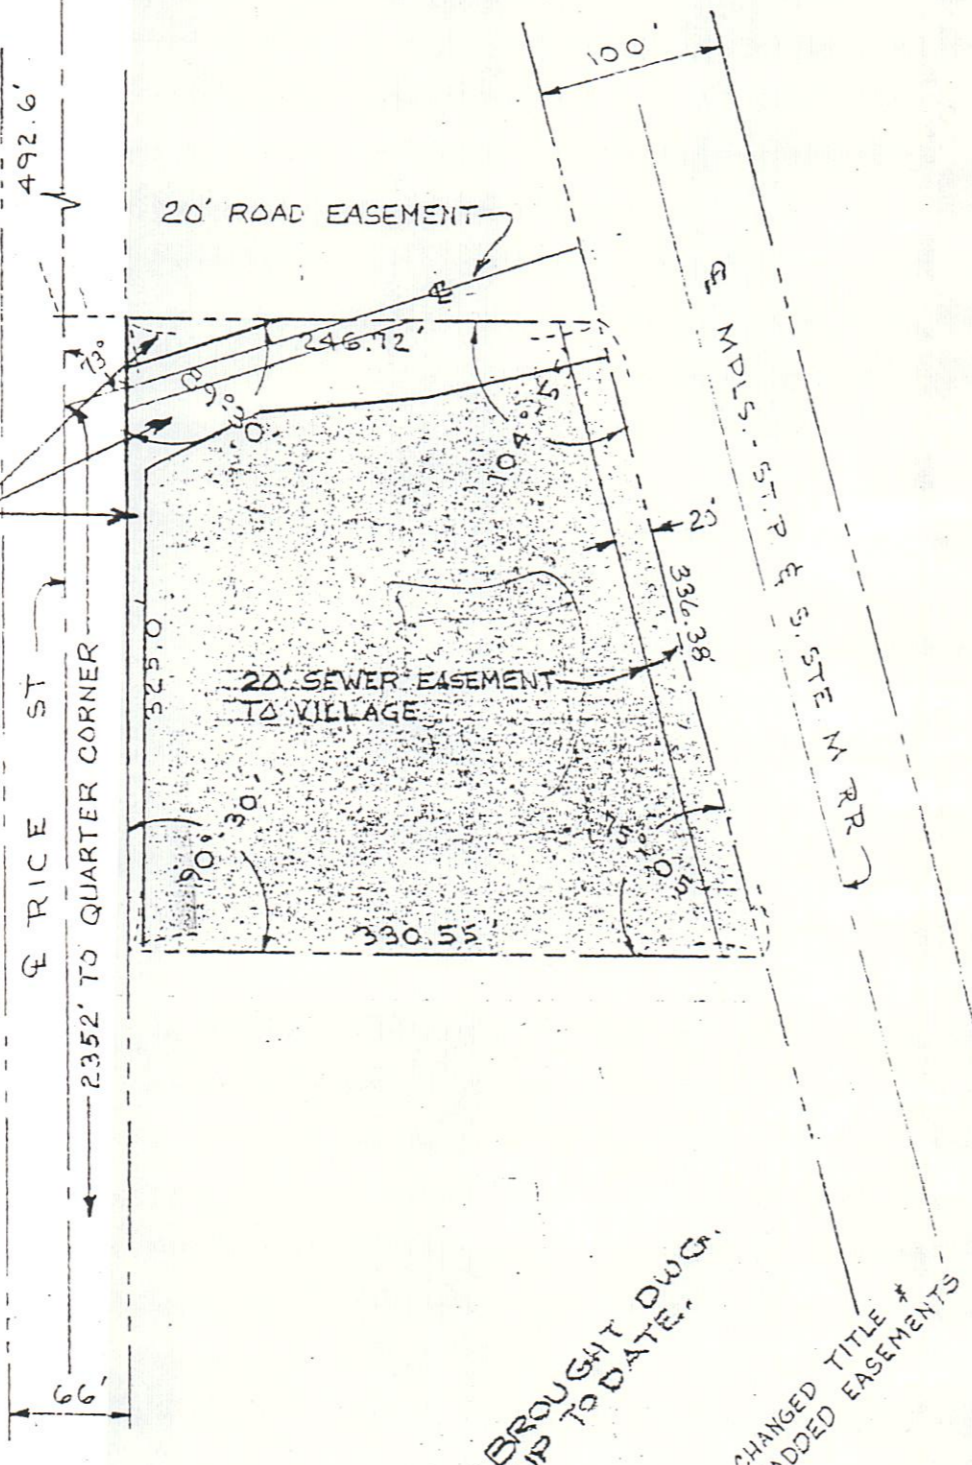

LEGEND

NSP CO. PROPERTY

LOCATION

A TRACT OF LAND IN THE NW  
1/4 OF SECTION 6 - T29N - R22W  
RAMSEY CO., MINN.  
ALSO SUBJECT TO A STANDARD OIL PIPELINE  
EASEMENT AS NOW LOCATED.

BROUGHT DWG.  
UP TO DATE.

CHANGED TITLE #  
ADDED EASEMENTS

ND-23414  
C

Ramsey Co.  
PIN# 06 24 22 22 0025

SIGNIFICANT No	1940					6220
GROUP		2	3	4	5	6

B	A	REVISION
—	—	ESTIMATE
—	—	WORK ORD
PG	K	DRAWN
TJC	RGK	CHECKED
9-9-66	9-25-69	DATE
R.O. [Signature]	[Signature]	APPROVED
7-11-66	10-7-67	FILMED

RAMSEY SUBSTATION  
PROPERTY PLAT 'A'

NORTHERN STATES POWER COMPANY  
ENGINEERING DEPARTMENT  
MINNEAPOLIS

SCALE 1"=100'  
ND-23414-B

9-17-66