Exhibit Sketch For:
TKDA
Warner Road Bridge Easement Documents

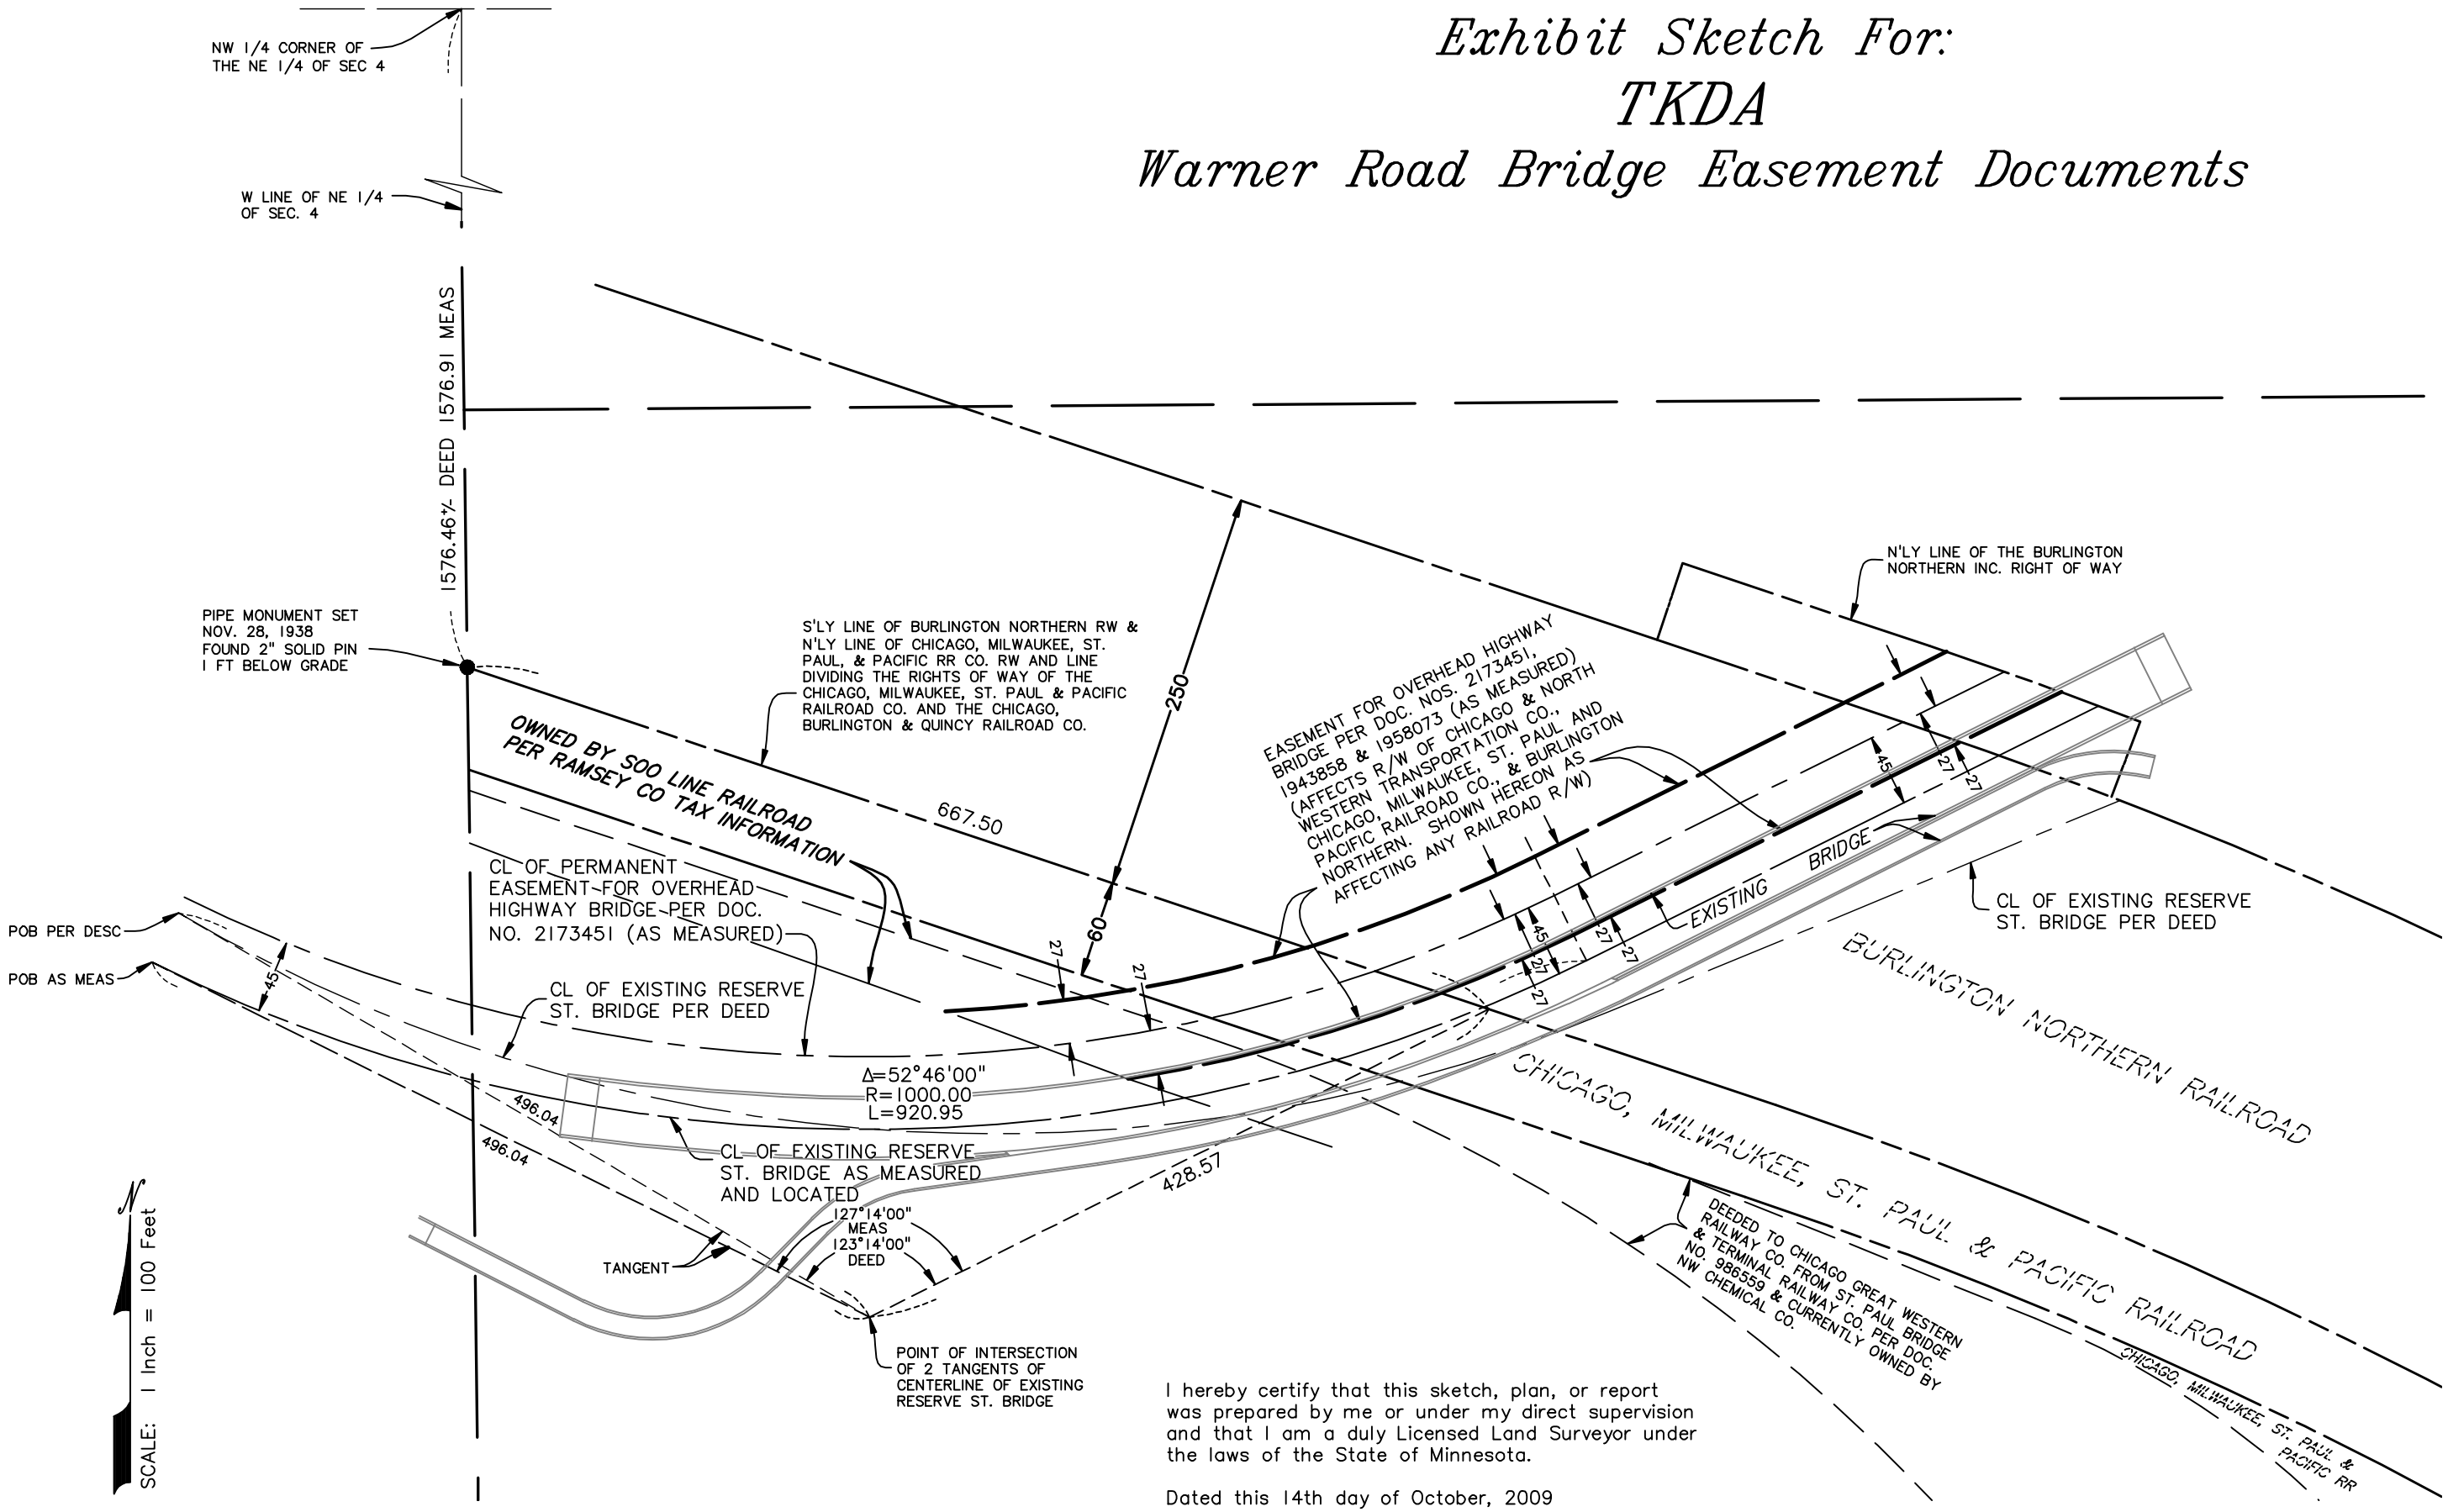

I hereby certify that this sketch, plan, or report was prepared by me or under my direct supervision and that I am a duly Licensed Land Surveyor under the laws of the State of Minnesota.

Dated this 14th day of October, 2009

SUNDE LAND SURVEYING, LLC.

By: Mark S. Hanson

Mark S. Hanson, P.L.S. Minn. Lic. No. 15480

SUNDE LAND SURVEYING
www.sunde.com

Main Office:
9001 East Bloomington Freeway (35W) • Suite 118
Bloomington, Minnesota 55420-3435
952-881-2455 (Fax: 952-888-9526)
North Office:
Brooklyn Park, Minn. 763-784-9346

2009-113 652/46 T.28 R.22 S.4 SMT 2009113004.dwg