

400 E. ST. GERMAIN ST.
ST. CLOUD, MN 56301
612-251-7751





314 OAK ST.
SAUK CENTRE, MN 56378
612-352-3664

500 W HWY 96, ST PAUL MN 55112 612-484-3301

I hereby certify that this Certificate of Survey Description Easement Plan Specification or Building Location was prepared by me or under my direct supervision and that I am a duly Registered Land Surveyor under the laws of the State of Minnesota.

Ce Roy Winner

Reg. No. 4987 Date 10-26-81
Revised Tracts: 11-4-81

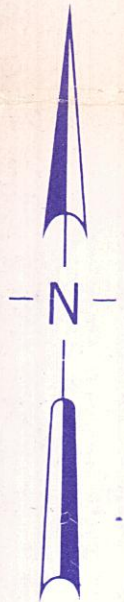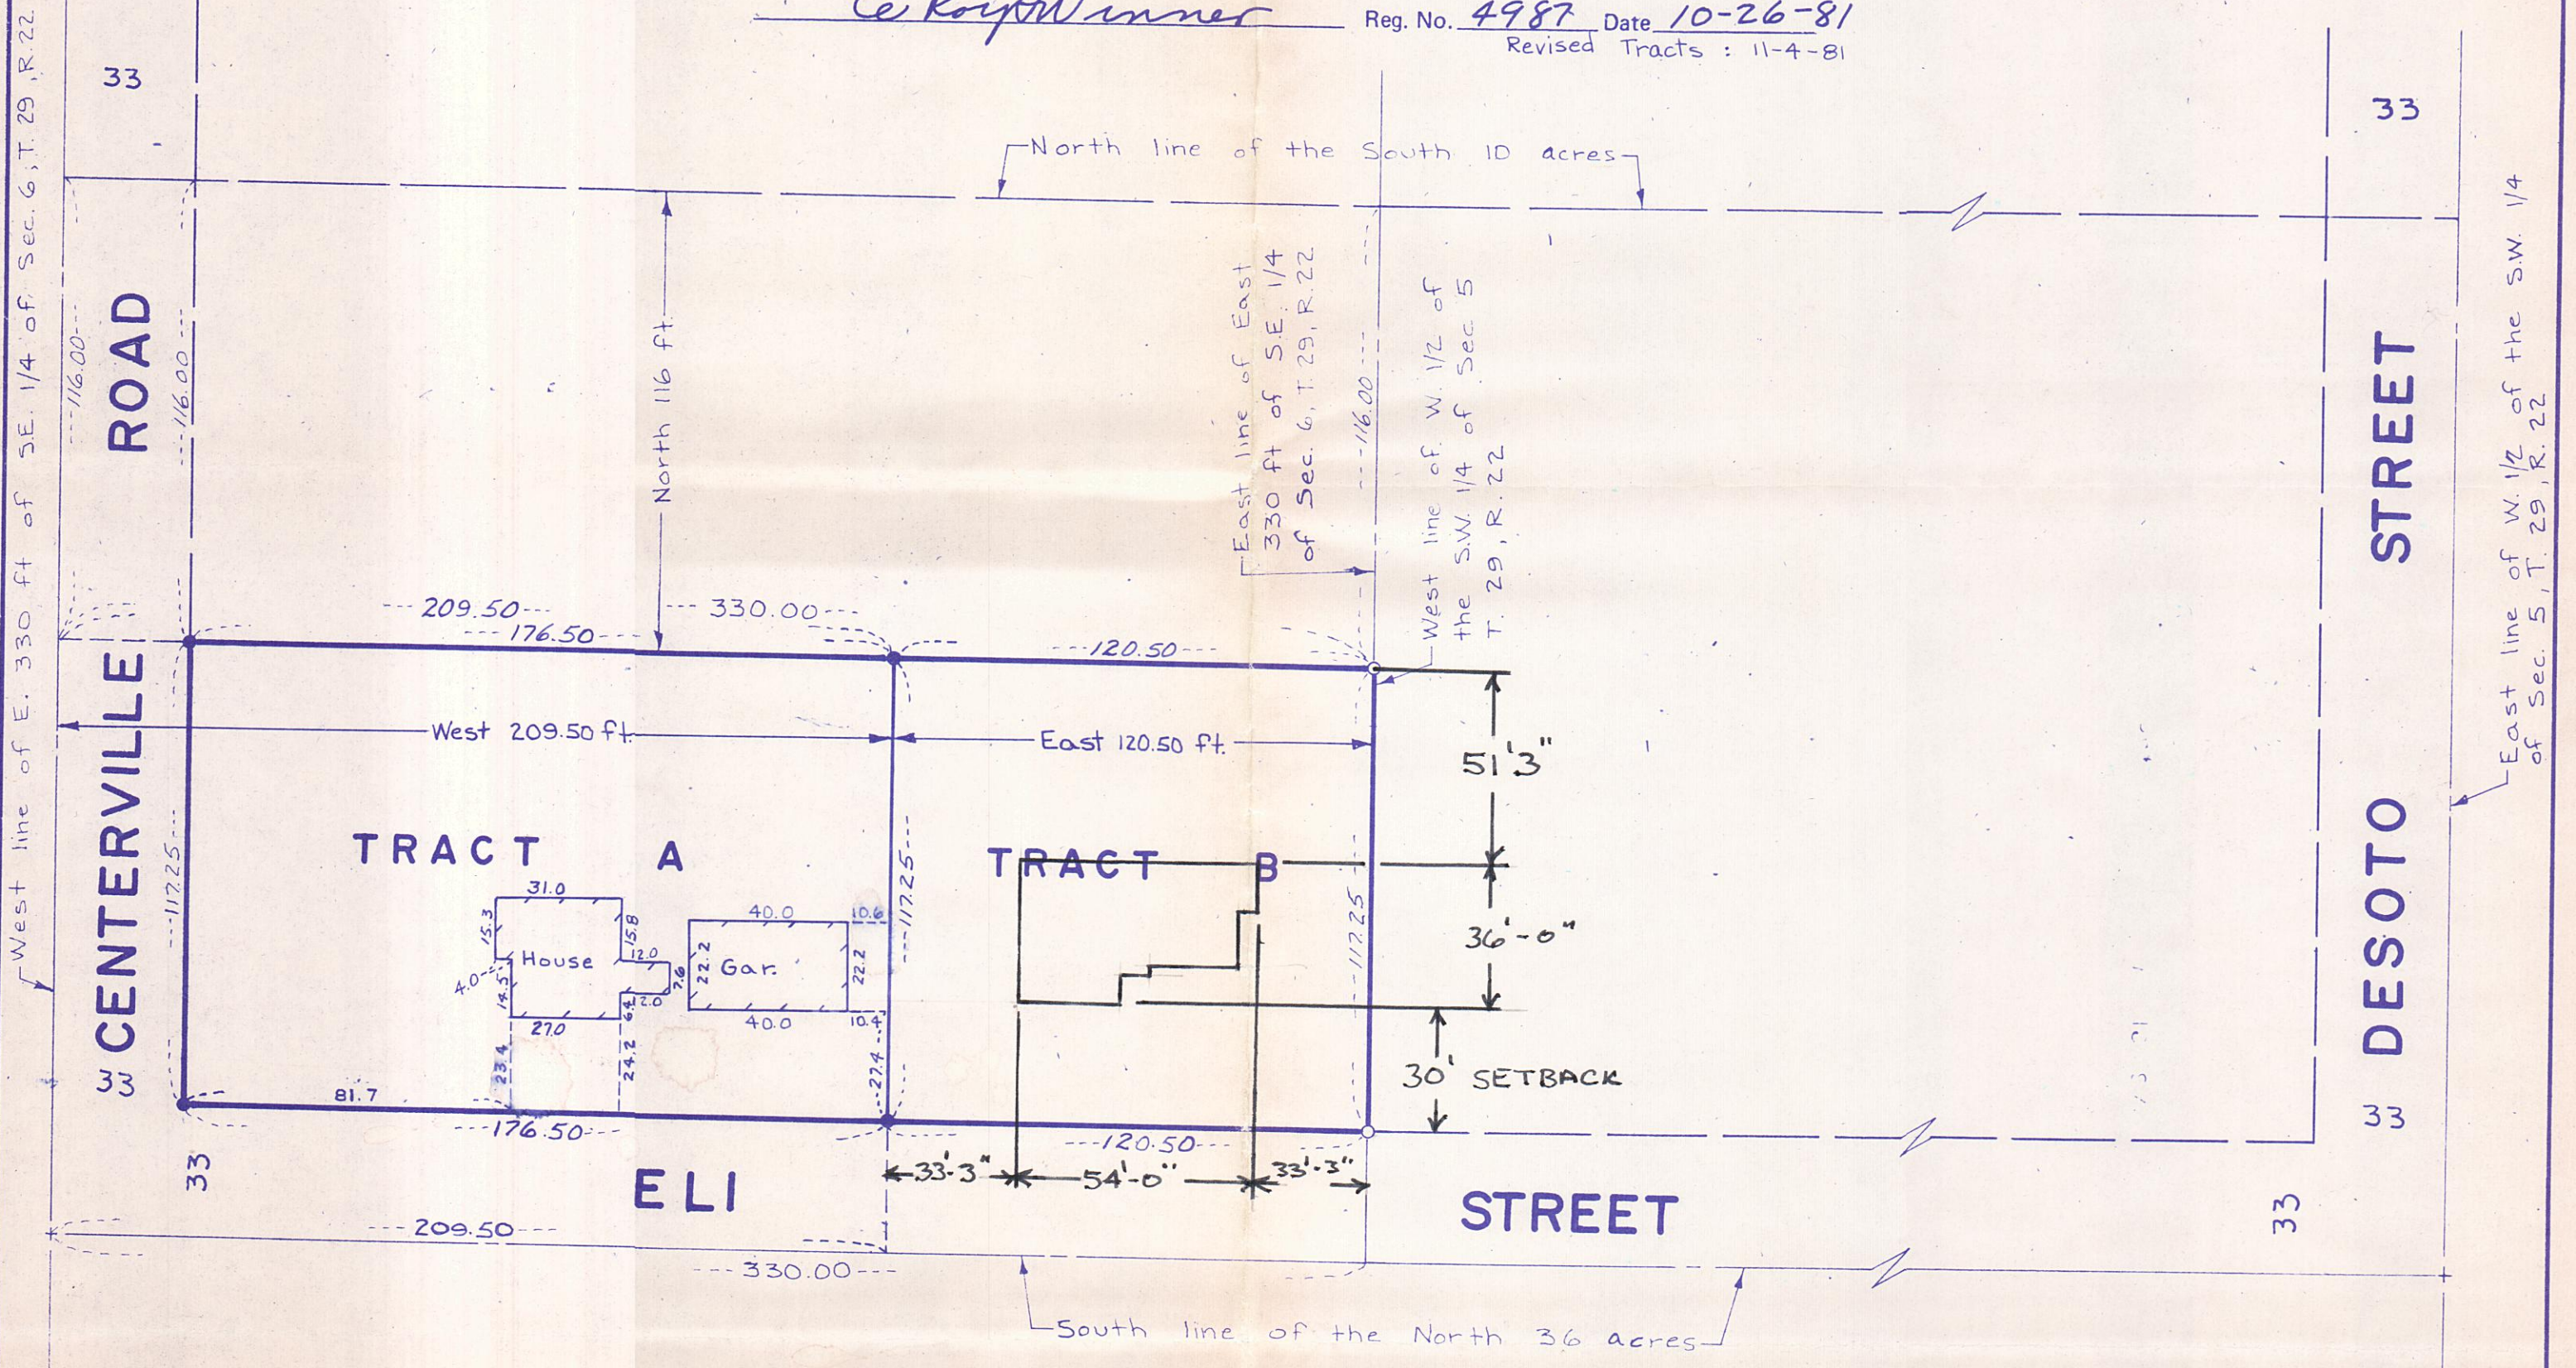

Scale: 1 inch = 40 feet

- o Denotes iron monument pd.
- Denotes iron monument set

TRACT A

The West 209.50 feet of the South 10 acres of the North 36 acres of the following: The East 330 feet of the SE 1/4 of Section 6 and the W 1/2 of the SW 1/4 of Section 5, Township 29, Range 22, Ramsey County, Minnesota, except the North 116 feet. Subject to Eli and Centerville Roads.

TRACT B

The East 120.50 feet of the West 330 feet of the South 10 acres of the following: The East 330 feet of the SE 1/4 of Section 6 and the W 1/2 of the SW 1/4 of Section 5, Township 29, Range 22, Ramsey County, Minnesota, except the North 116 feet. Subject to Eli Road.