
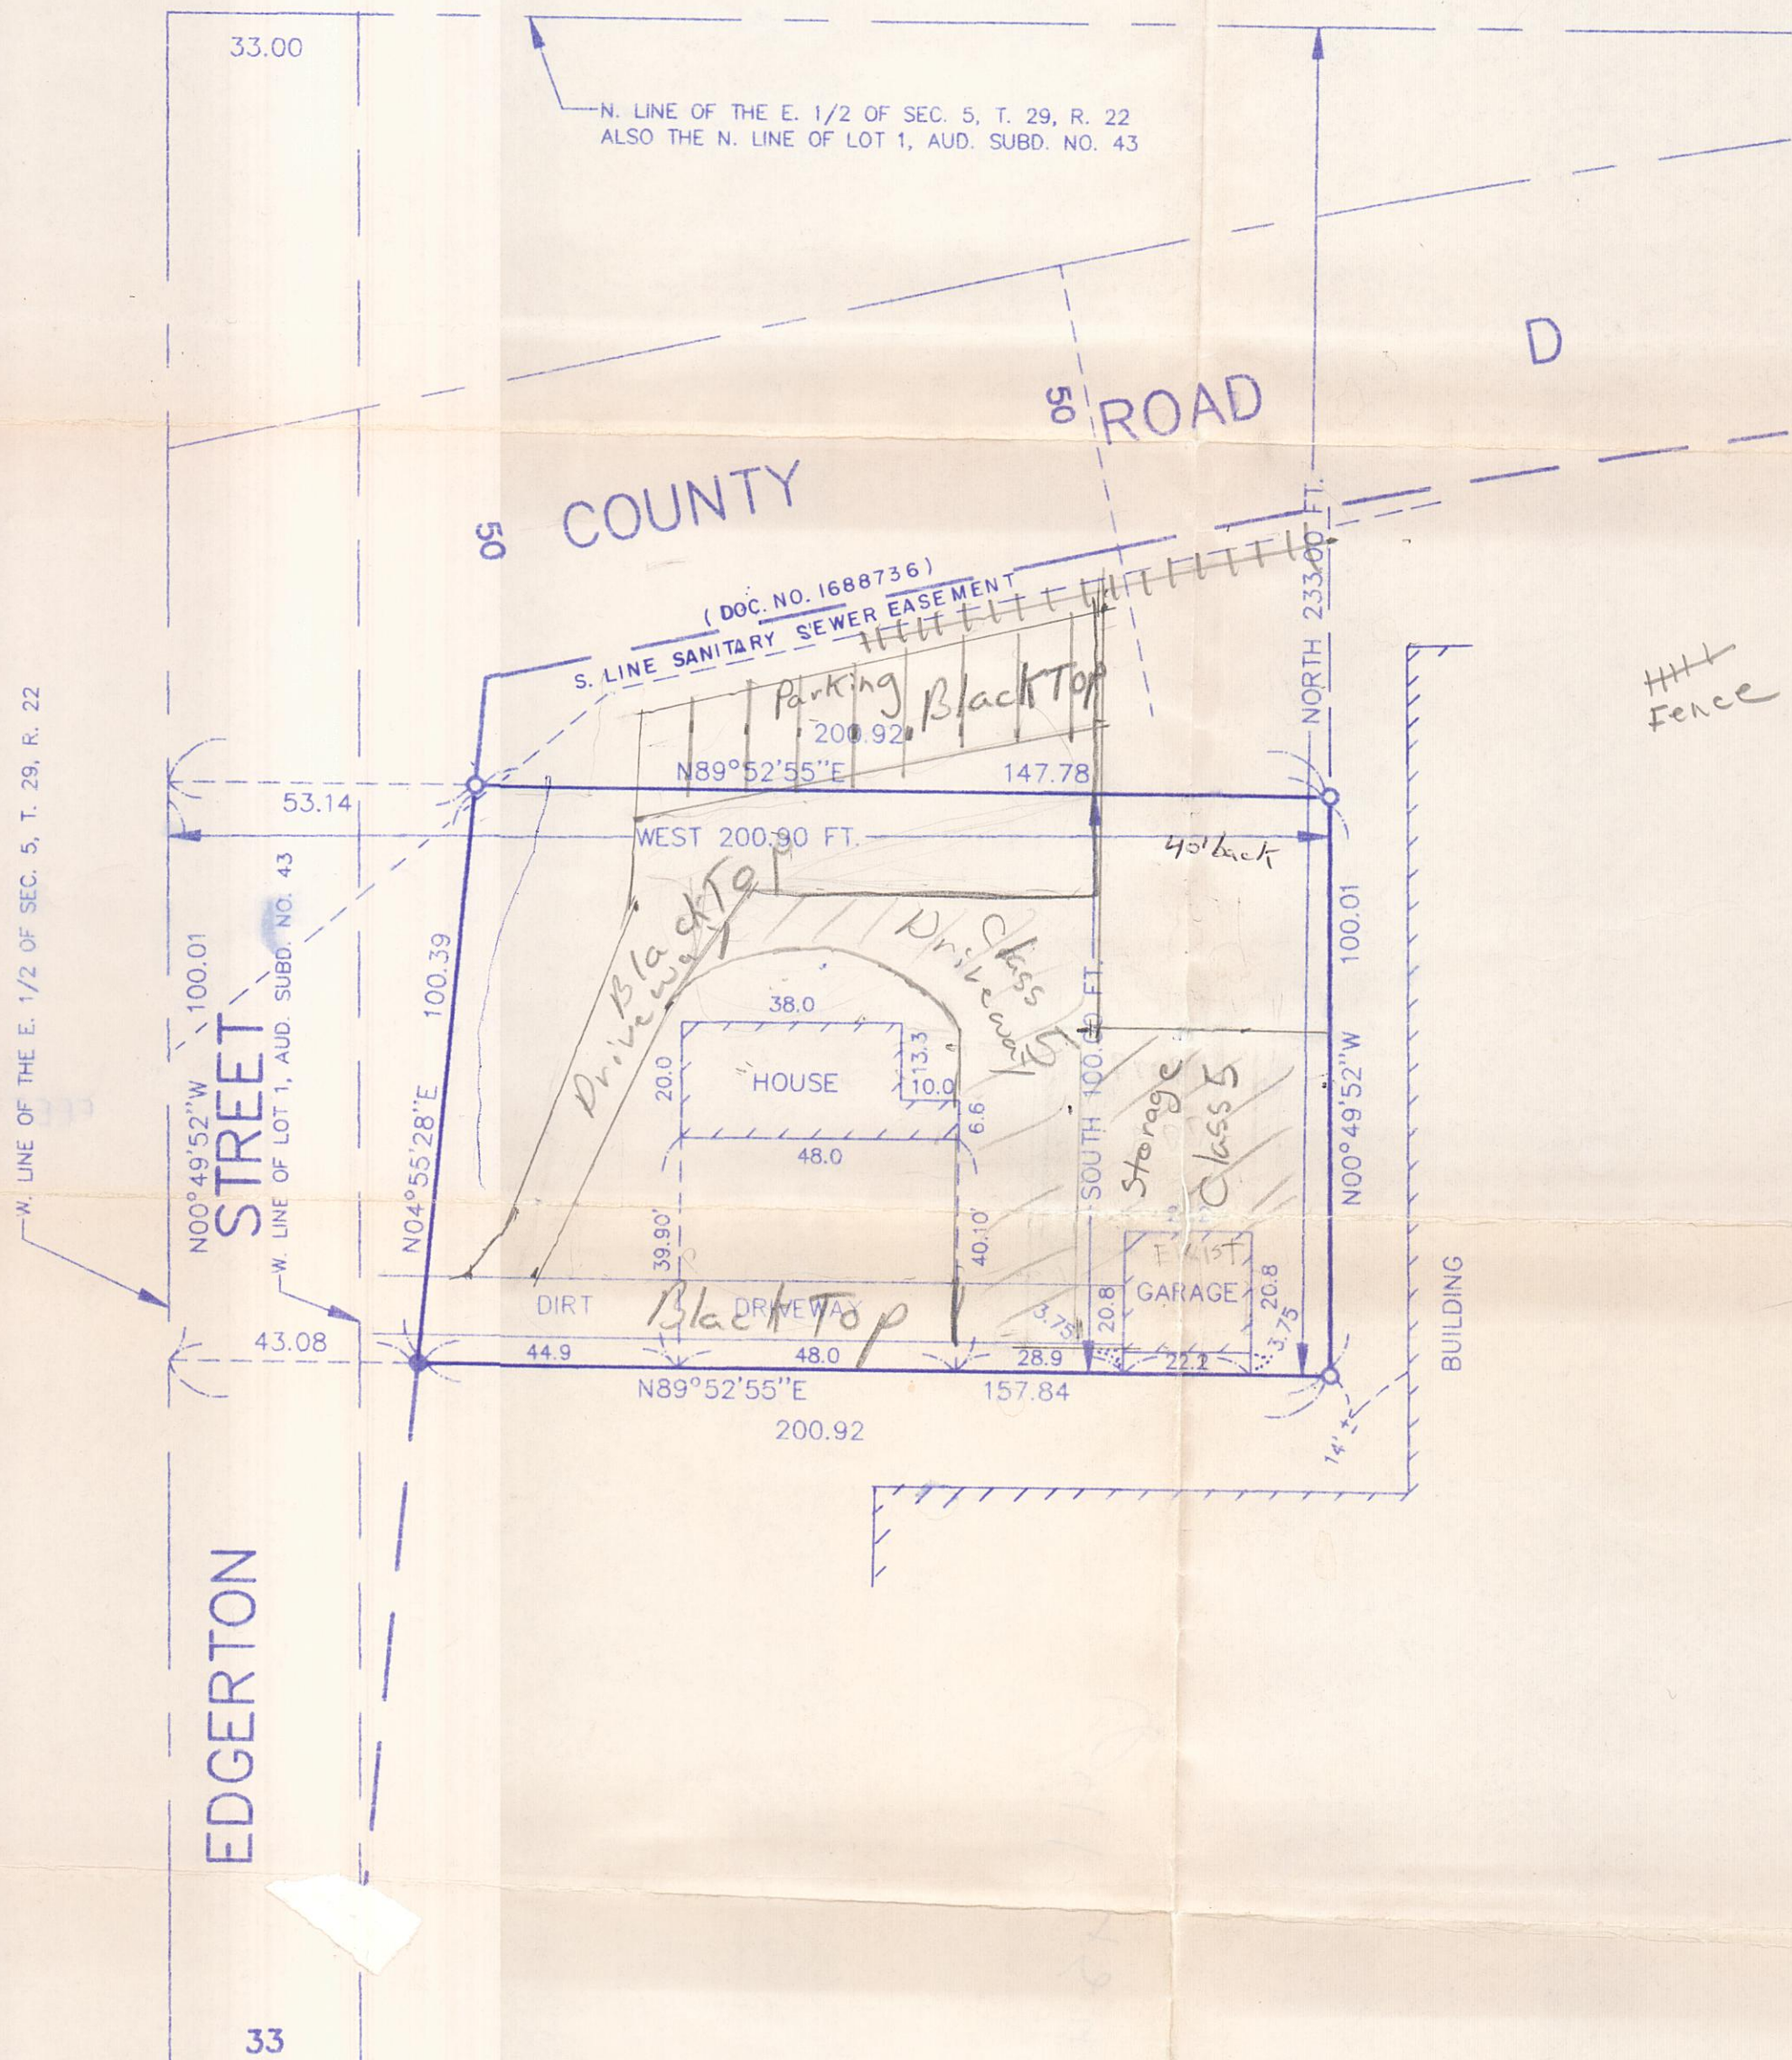


# CERTIFICATE OF SURVEY FOR: ROBERT E. BUETOW

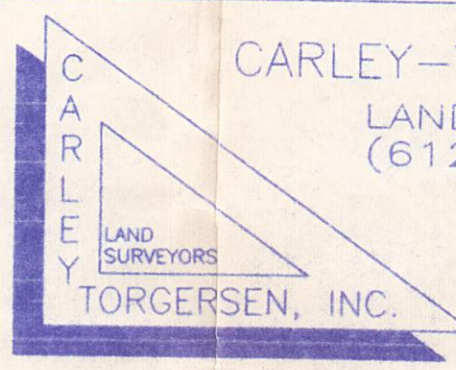

RECEIVED APR 22 1999

The south 100.00 feet of the north 233.00 feet of the west 200.90 feet of the East Half of Section 5, Township 29, Range 22, Ramsey County, Minnesota excepting that part conveyed to the State of Minnesota for highway purposes.

	<p style="text-align: center;"><b>CARLEY-TORGENSEN, INC.</b> LAND SURVEYORS (612) 484-3301</p> <p style="text-align: right;">SUITE 703 70 WEST COUNTY ROAD "C" LITTLE CANADA, MN. 55117</p>	<p>I hereby certify that this survey, plan or report was prepared by me or under my direct supervision and that I am a duly Registered Land Surveyor under the laws of the State of Minnesota.</p> <p style="text-align: center;"><i>David E. Torgersen</i> David E. Torgersen, P.L.S. Minn. Reg. No. 17551 Date <u>4-7-95</u></p>
<p>Revision Date _____ Book No. 665-76 Job No. 95-029 File No. 9441</p>		