
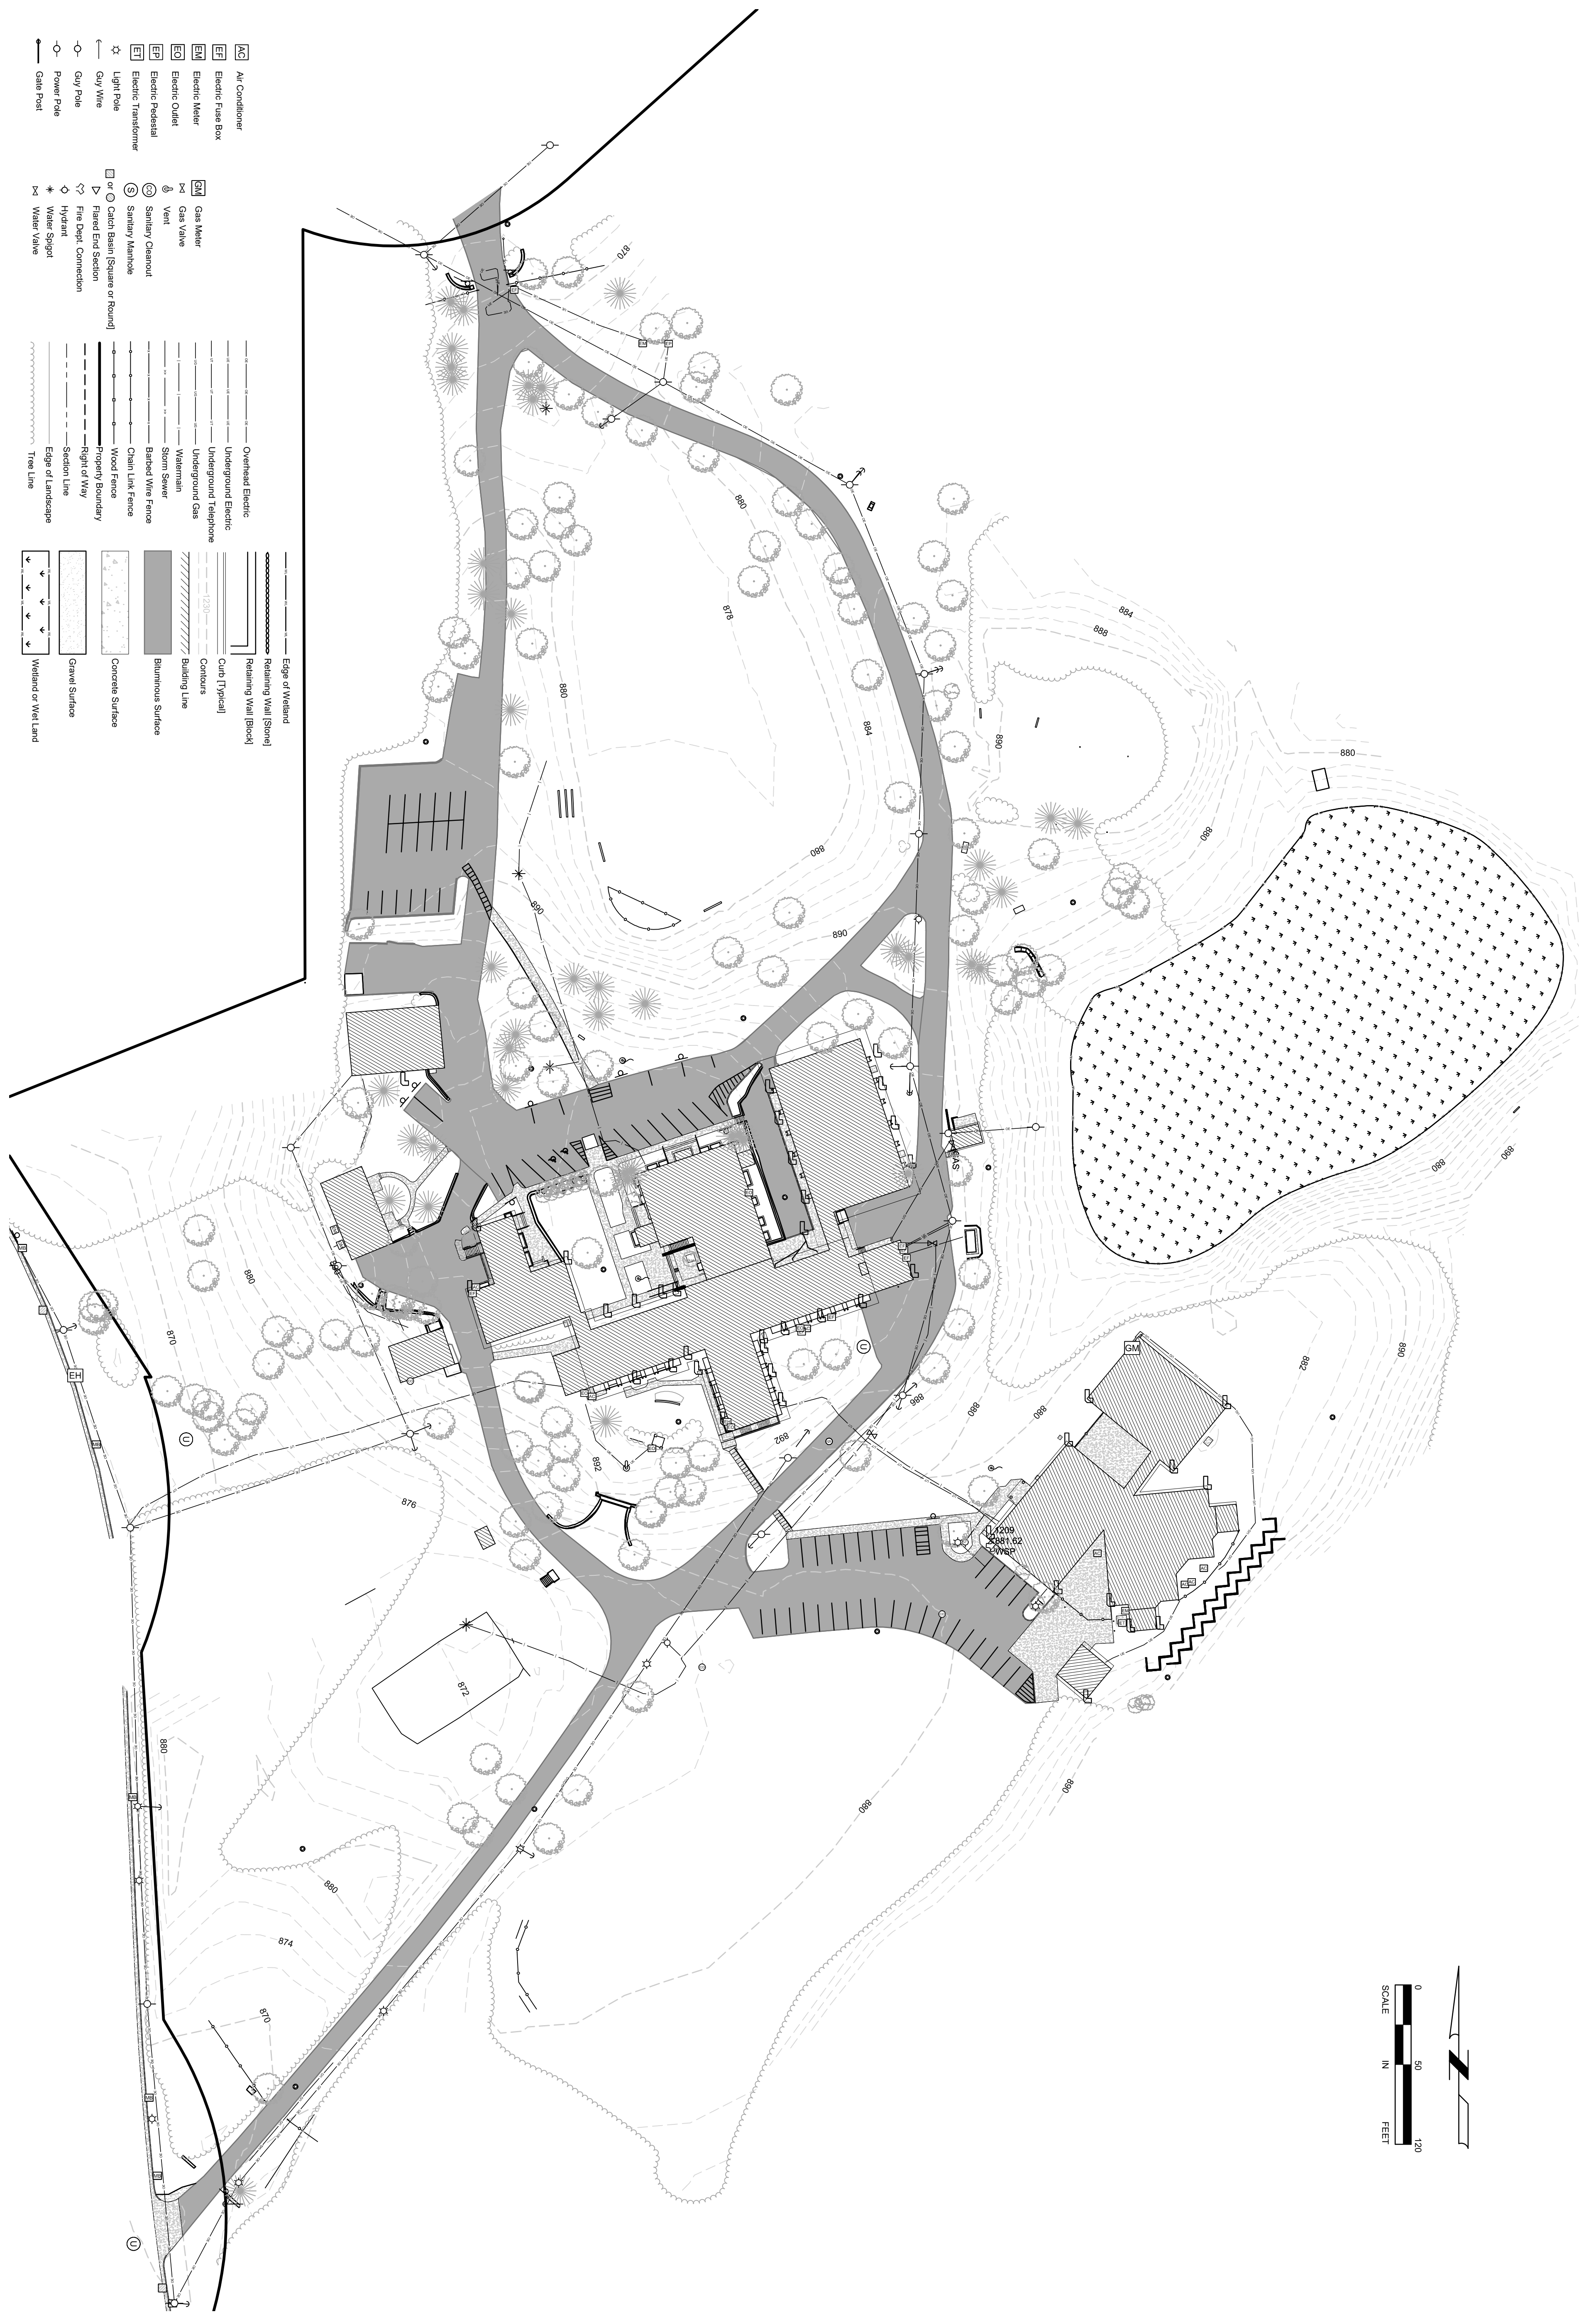


ALTA/NSPS Land Title Survey -FOR- Ramsey County
-OF- Boys Totem Town, Ramsey County, Minnesota

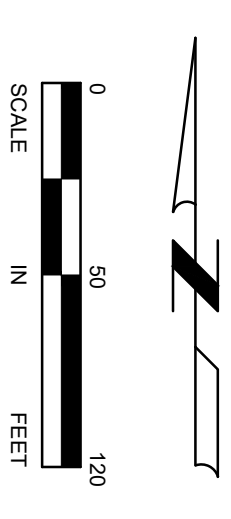

- | | | | | |
|--|---|--|--|--|
| <ul style="list-style-type: none"> ⑤ Survey Note ○ Found Cast Iron Monument ● Found Monument (As Noted) ○ Control Point ○ Condensate Tree ○ Condensate Tree ○ Deciduous Tree ○ Ballast ○ Flag Pole ○ Mail Box ○ Unknown Manhole ○ Large Rock | <ul style="list-style-type: none"> AC Air Conditioner EF Electric Fuse Box EM Electric Meter EO Electric Outlet EP Electric Pedestal ET Electric Transformer ☆ Light Pole ○ Guy Wire ○ Guy Pole ○ Power Pole ○ Gate Post | <ul style="list-style-type: none"> GM Gas Meter GV Gas Valve ⊕ Vent ⊕ Sanitary Cleanout ⊕ Sanitary Manhole ⊕ or ○ Catch Basin (Square or Round) ⊕ Flared End Section ⊕ Fire Dept. Connection ⊕ Hydrant ⊕ Water Signal ⊕ Water Valve | <ul style="list-style-type: none"> Overhead Electric Underground Electric Underground Telephone Underground Gas Watermain Sewer Storm Sewer Barbed Wire Fence Chain Link Fence Wood Fence Property Boundary Right of Way Section Line Edge of Landscape Tree Line | <ul style="list-style-type: none"> Edge of Wetland Retaining Wall (Stone) Retaining Wall (Block) Cut (Typical) Concrete Building Line Asphalt Gravel Surface Grass Surface Wetland or Wet Land |
|--|---|--|--|--|

PLOTTED: 2020.01.23 10:27 AM
 PROJECT: 2019.20.022 Boys Totem Town (BTT) ALTA/NSPS Land Title Survey 2019.20.022
 PLOT: 2020.01.23 10:27 AM

SHEET #	Boys Totem Town 398 Totem Rd St Paul, MN 55119		REVISIONS	DATE	01-31-2020
2 of 3			01-31-2020	FIELD	MPV
PROJECT #	ALTA/NSPS Land Title Survey			DRAWN	MPV
2019.20.022				CHECKED	JJH

2912 Anthony Lane
Suite 100
Minneapolis, MN 55418
P: 612.455.3322
www.ranienr.com

