

CERTIFICATE OF SURVEY




DESCRIPTION

Lot 9, Block 33, WHITE BEAR, Ramsey County, Minnesota

Prepared for and at the request of:
 Owner: Mike Pappas
 4841 Lake Avenue
 White Bear Lake, Minnesota 55110

LEGEND


- iron monument found
- Set 5/8" steel rebar capped RLS17496

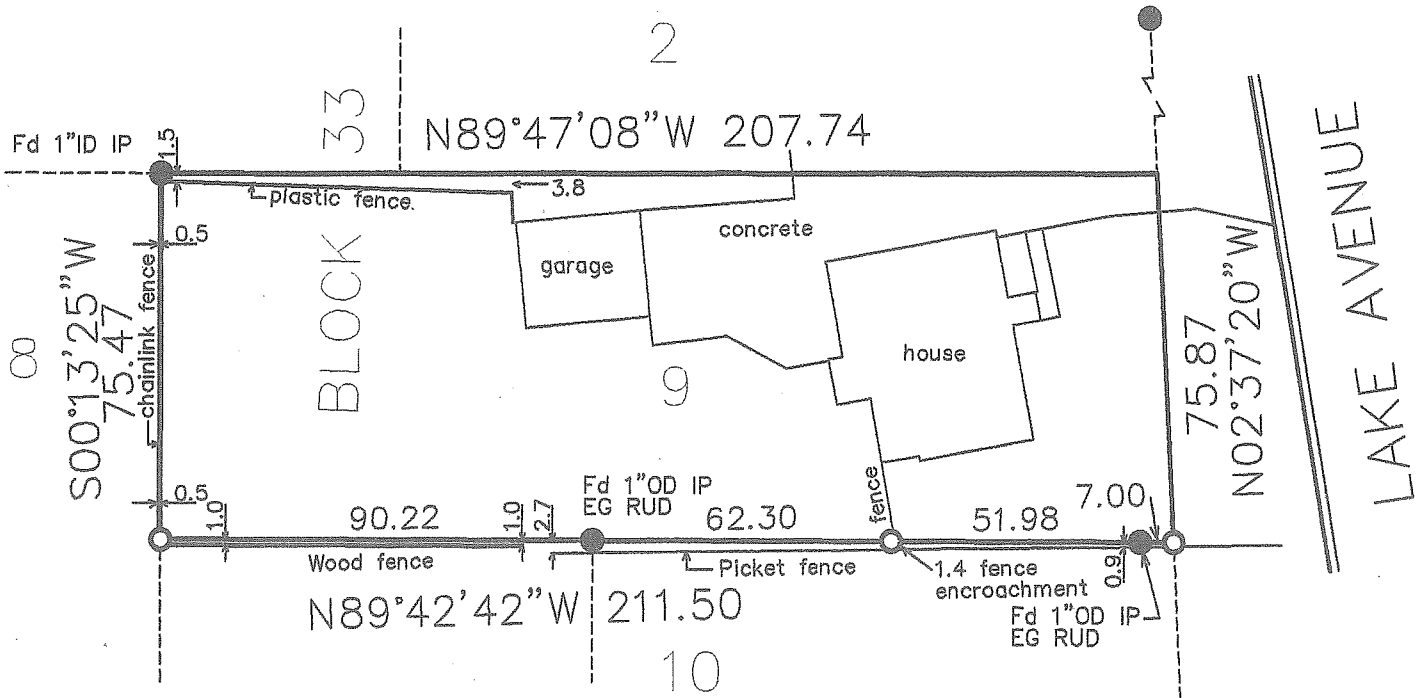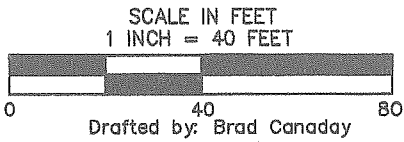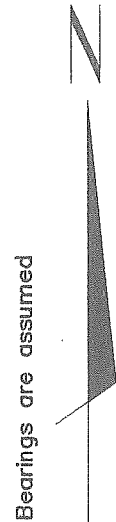

Prepared by:
 BRADLEY CANADAY
 SURVEYING
 6976 26th St Ct N,
 Oakdale, MN 55128
 Ph No. 651-332-6890

Job No. 23-13

I hereby certify that this survey, plan or report was prepared by me or under my direct supervision and that I am a duly Registered Land Surveyor under the laws of the State of Minnesota.


 Date 11/29/23 Reg. No. 17496